

# WILL ROBINSON & ASSOCIATES

AM N. ROS SSERED ENG. 13 ORICLITURE: 223 CONDICTOR STATE OF TENNESS

s Custard

REVISIONS: 02/14/2023 PLANNING COMMENTS

DRAWN: WNR
CHECKED: WNR


DATE: 01–06–2022

FILE NAME:

PROJECT NO:

PLO1

CONCEPT DEMOLITION PLAN
DRAWING

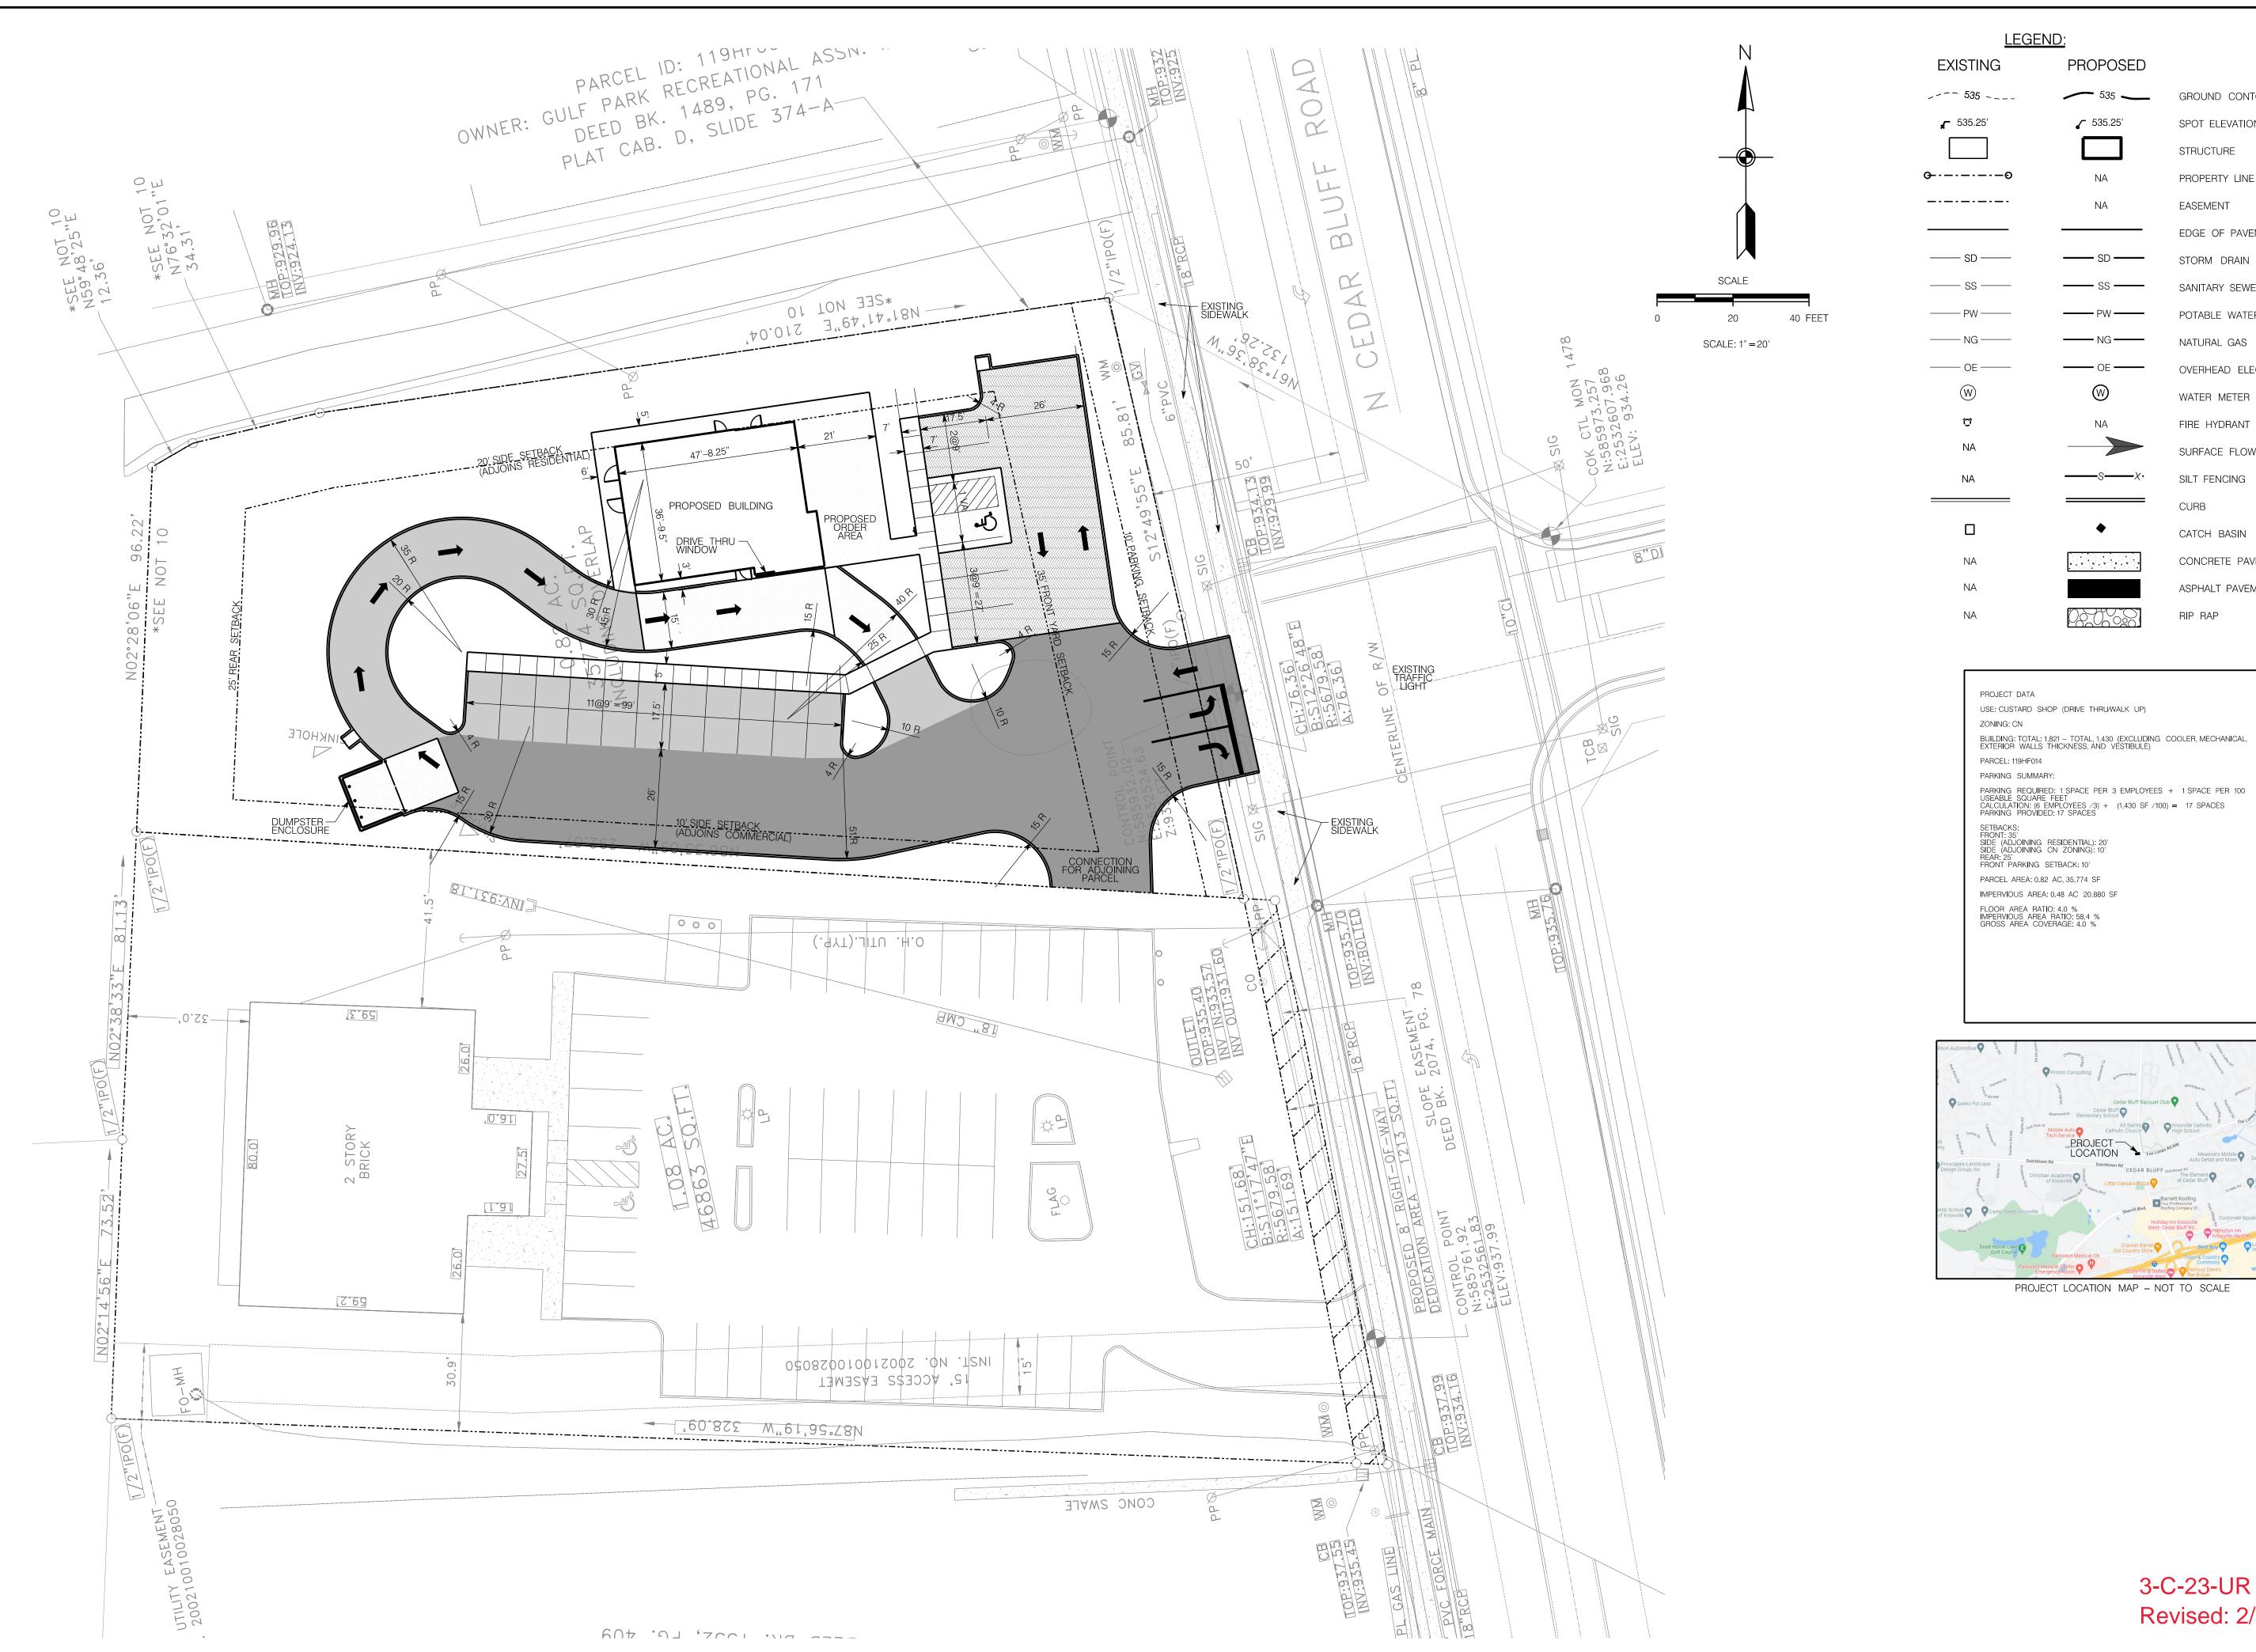

#### LEGEND: PROPOSED GROUND CONTOUR ELEVATION **5**35.25 SPOT ELEVATION STRUCTURE PROPERTY LINE EASEMENT EDGE OF PAVEMENT STORM DRAIN

SANITARY SEWER

POTABLE WATER

OVERHEAD ELECTRICAL

NATURAL GAS

WATER METER

FIRE HYDRANT


SURFACE FLOW

SILT FENCING

CATCH BASIN

CONCRETE PAVEMENT

ASPHALT PAVEMENT

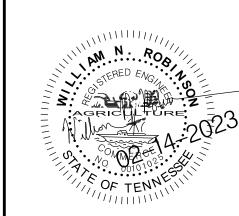


**REVISIONS:** 02/14/2023 PLANNING COMMENTS


DRAWN: WNR CHECKED: WNR DATE: 01-06-2022 FILE NAME:

PROJECT NO:

3-C-23-UR Revised: 2/20/2023



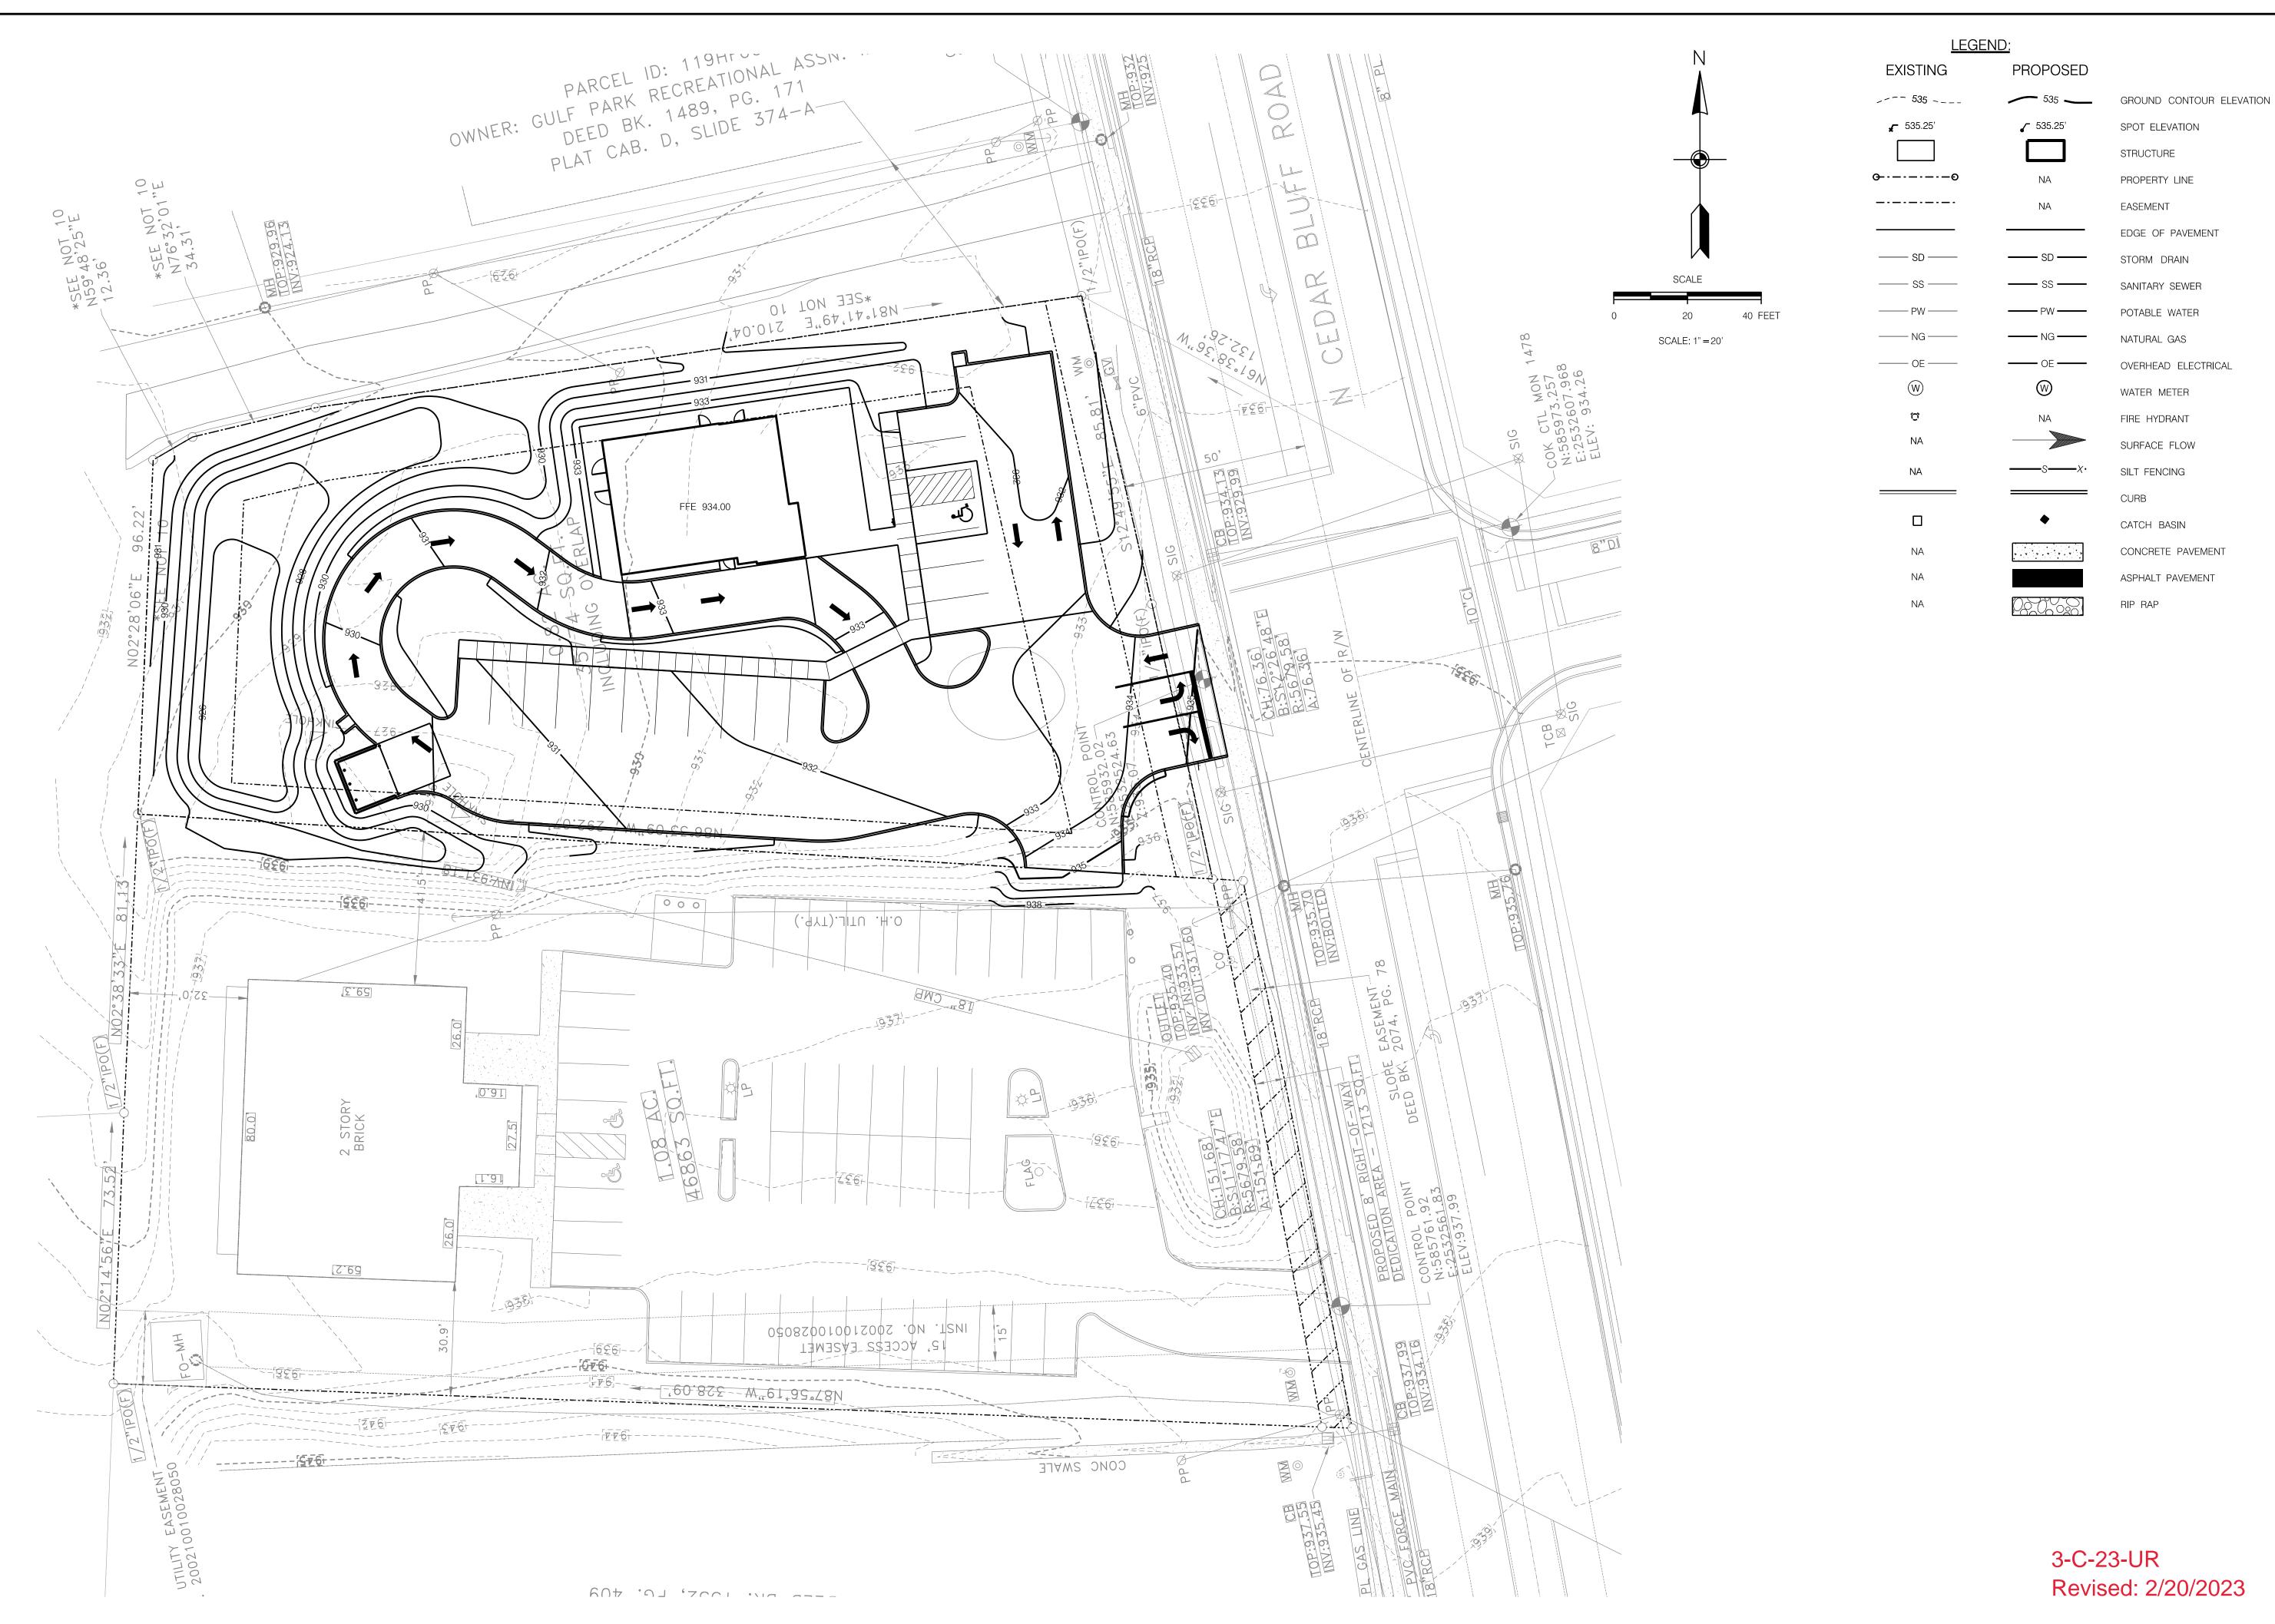

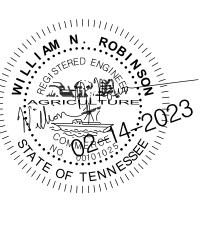

REVISIONS: 02/14/2023 PLANNING COMMENTS

DRAWN: WNR CHECKED: DATE: 01-06-2022


FILE NAME: PROJECT NO:

CONCEPT GRADING PLAN DRAWING

# Andy's Custard

513 North Cedar Bluff Road Knox County, TN 37923

## Landscape Package

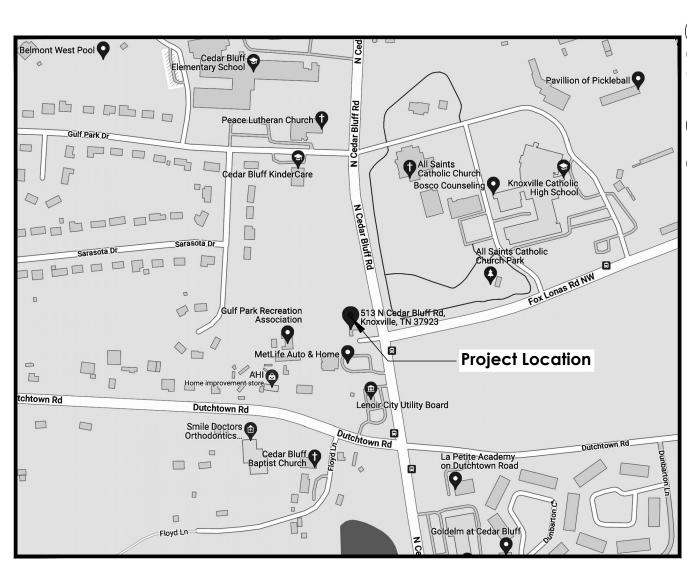

Vicinity Map: NTS

#### Landscape Package Sheet Index

- L000 Cover Sheet
  L100 Landscape Plan
- L200 Planting Details
  - Planting Notes & Plant Schedule

#### Landscape Architect Contact Information

#### Shippey Landscape Architecture

Philip Shippey, PLA Phone: 229.326.1179 Email: philip@shippeyla.com

### Mailing Address: P.O. Box 2961

P.O. Box 2961 Cleveland, TN 37320

#### Property Information

- 1. Local jurisdiction: Knox County
- Current Zoning: CN
   Parcel #: 119HF014
- 4. Deed Reference: 20170601-0073532
- 5. Proposed Use: Custard Shop (Commercial)
- 6. Property Area: 0.82 acres

#### Abbreviation Reference

- 1. LF = Linear Feet
- SF = Square Feet
   o.c. = On Center
- 4. typ. = Typical
- 5. Ex. = Existing6. EQ. = Equal
- 7. ± = Plus or minus8. Qty. = Quantity
- 9. Cal. = Caliper
- 10. Gal. = Gallon 11. Hgt. = Height
- 12. Approx. = Approximate
- 13. CT = Clear Trunk
- 14. Min. = Minimum
- 15. Max. = Maximum16. Cu. Yd. = Cubic Yard
- 17. PTD = Pitch to Drain18. TBD = To be Determined



**SHIPPEY** 

P.O. Box 2961 Cleveland, TN 37320 229.326.1179 | philip@shippeyla.co shippeyla.com

513 Cedar Bluff Road
Knox County, TN 37923

Drawn ByDatePBS02/17/2023RevisionDate1. Planning Comments02/17/2023


Sheet Name

Cover Sheet


Sheet Number

L000

3-C-23-UR Revised: 2/20/2023

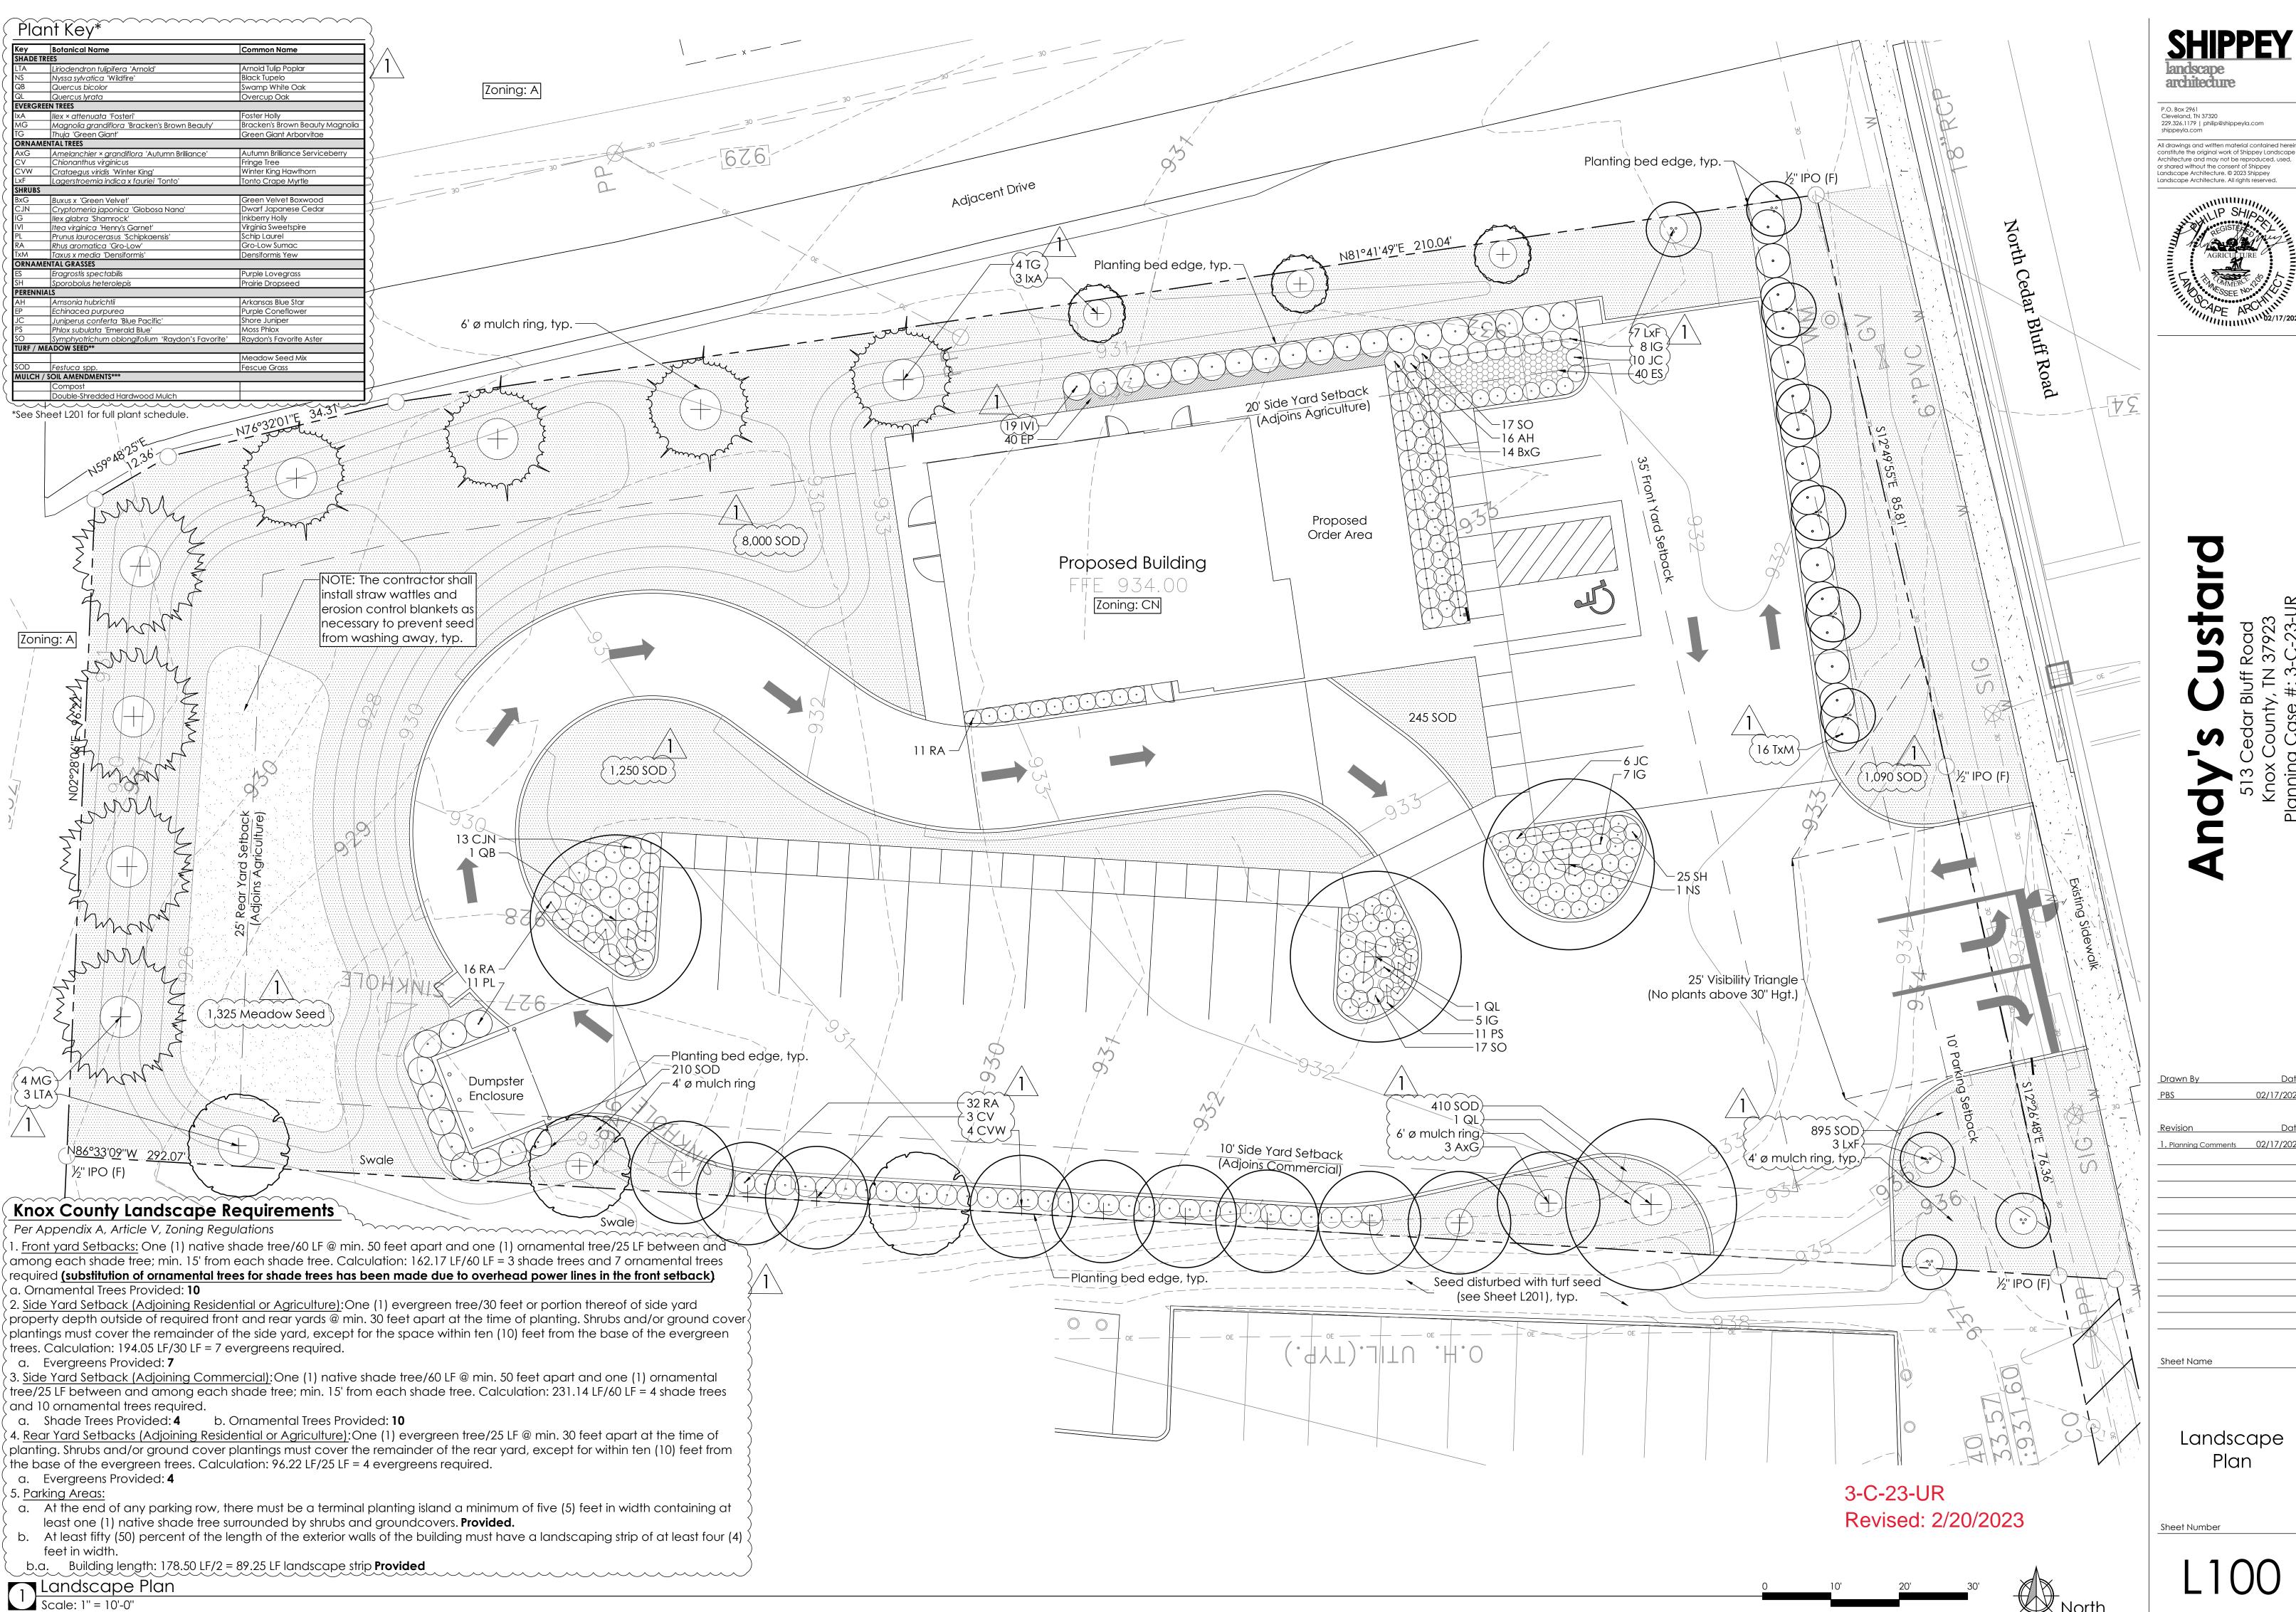



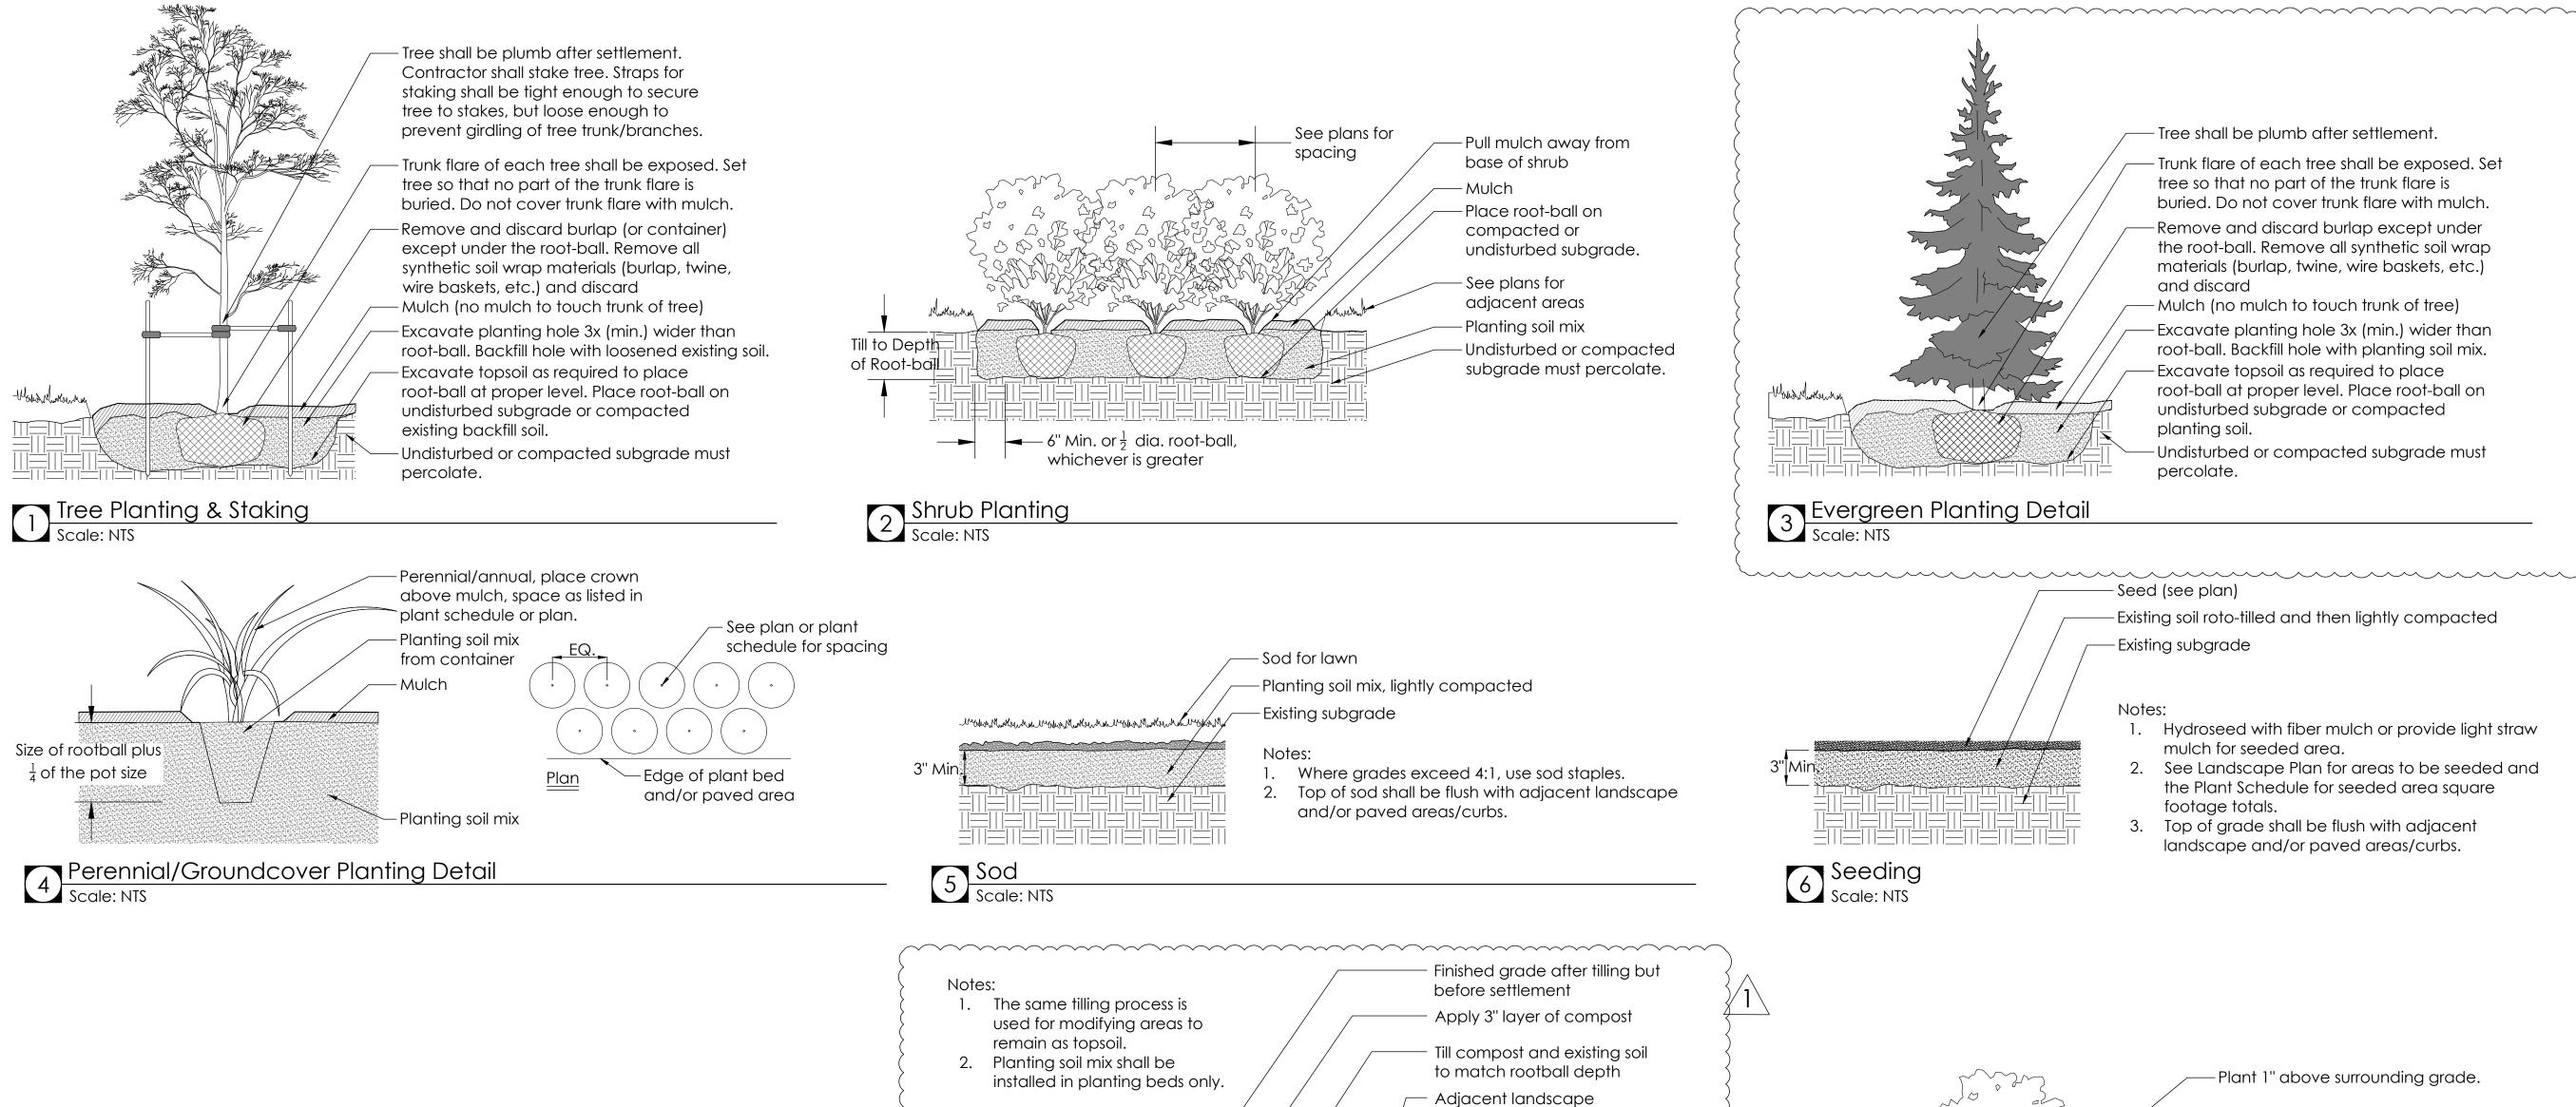

8 Planting Soil Mix Scale: NTS

(see plan)

- Existing soil

Lawn

Muskan maken of the Markey of

7 Planting Bed Edge Scale: NTS —Planting soil mix

-Cut a 'V' as shown on edges of all plant beds. Min. depth 4"

Plant 1" above surrounding grade.

Roll burlap back from top \$\frac{1}{3}\$ of root-ball before backfilling. Remove rope from trunk.

Mulch; soil not to be visible once mulch is compacted

3" high earth saucer

Compacted bench under plant

Planting soil mix

Slope Planting Detail

Scale: NTS

3-C-23-UR Revised: 2/20/2023 SHIPPEY
landscape
architecture

P.O. Box 2961
Cleveland, TN 37320
229.326.1179 | philip@shippeyla.com
shippeyla.com

All drawings and written material contained herein
constitute the original work of Shippey Landscape
Architecture and may not be reproduced, used,
or shared without the consent of Shippey
Landscape Architecture. @ 2023 Shippey
Landscape Architecture. All rights reserved.



dy's Cust Road
513 Cedar Bluff Road

Drawn By

PBS

02/17/2023

Revision

Date

1. Planning Comments

02/17/2023

Sheet Name

Planting Details

Sheet Number

200

#### Planting Notes

- 1. The Contractor shall verify existing conditions 12. Thoroughly water **all** plants during the first 24 in the field and report any discrepancies to the Landscape Architect prior to starting work.
- 2. No planting shall occur until soil test sample results have been received and the soil has been amended per the soil test results. See this sheet for for soil testing instructions.
- 3. No planting shall occur until percolation testing has been completed and soils have be properly graded for positive drainage. procedures.
- 4. All new plant material shall to conform to the guidelines set for nursery stock published by Additionally, all new plant material for the project shall be of the highest specimen quality.
- 5. Do not assume that trunk flares will be exposed at the nursery. Contractor to expose trunk flares to check for girdling. Pull mulch away from the base of all plants.
- 6. All new plants shall be balled and burlapped or container grown unless otherwise noted on the plant schedule.
- 7. The Contractor shall locate and verify all utility lines prior to soil preparation or planting. Any discrepancies shall be reported to the Landscape Architect. Call Tennessee 811 to schedule a utility locate.
- 8. Till all beds with planting soil mix to a 19. Application of pesticides must be approved minimum depth that matches the depth of the plant root-balls.
- 9. All plant beds and trees shall receive a minimum of three inches (3") of double-shredded, hardwood mulch. See Seeding Notes on this sheet for mulching of seeded areas.
- 10. All shade and large evergreen trees in lawn areas shall have a minimum 6' diameter mulch ring to surround the base of the trunk 21. Mulch, compost, and sod quantities are unless noted otherwise on the plan. All ornamental and small evergreen trees shall have a minimum 4' diameter mulch ring to surround the base of the trunk unless noted otherwise on the plan.
- 11. Do not pile mulch against the trunk of any tree. Leave a gap for the trunk flare. Avoid mulch volcanoes.

- hours after planting. Wet the soil to a depth of 18-24". When water starts to run off, stop watering, let the water soak in and repeat until the proper depth is wet.
- 13. Any proposed substitutions of plant species shall be made with plants of equivalent form, height, branching, habit, leaf color, fruit and environmental culture. All proposed substitutions must be approved by the Landscape Architect.
- See this sheet for percolation testing 14. The Contractor's base bid shall include all materials, labor, permits, equipment, tools, insurance, etc. to perform the work as described in the contract documents.
- the American Association of Nurserymen, 15. The Contractor shall complete work within schedule established by the Owner or Owner's representative.
  - 16. The Contractor shall provide a one (1) year warranty for all plant material starting after the issuance of the certificate of occupancy. See specifications for more information regarding the plant warranty.
  - 17. Plant material delivered to the site that does not meet the requirements stated herein may be rejected by the Owner, Owner's Representative, or Landscape Architect.
- existing underground and aboveground 18. Contractor to provide interim maintenance (watering, pruning, fertilizing, trimming, adequate drainage of ponding areas, edging, weeding, mulching, and general landscape clean-up) until end of warranty.
  - by the Landscape Architect or Owner prior to use. All pesticide applications shall be carried out by a licensed spray technician.
  - 20. Planting plans are not layout plans. Plants may need to be shifted in the field to accommodate existing conditions. Coordinate with the Landscape Architect before making any changes to the planting plan.
  - approximate. The Contractor shall verify the amount needed before purchasing and installina.

#### Soil Test Notes

- 1. Using a shovel, dig a v-shaped hole to a depth of 6 inches; then cut a thin slice of soil from one side of the hole. Place the slice of soil into a plastic bucket (do not use a metal bucket as this can skew test results). Mix the slices together and fill a plastic sample bag with three (3) cups of soil. The sample bags can be ziploc bags that clearly labeled with the project name and sample number.
- 2. A well-mixed composite from 10 to 20 random locations from the areas to receive plants shall be sub-sampled to make the three (3) cup sample for each bag.
- 3. Mark the landscape plan to show sample locations.
- 4. Send the soil samples to either a private lab or the local extension service.
- 5. The results of the soil test shall be sent to the Landscape Architect for evaluation.

#### Soil Percolation Test Notes

- 1. Dig hole 18-24" deep and a minimum of 6" wide.
- 2. Fill hole with water to the top and let it drain for several hours. Ideally, let the hole pre-wet over night and perform the test the following day.
- 3. Refill hole to within a couple of inches of the top.
- 4. To aid in measurement, place a stick across the top of the hole and use a second stick to mark periodic drops in water level; mark side of hole; or mark on side of hole with nail or stick.
- 5. Measure drop in water level after 30 minutes and again at 1 hour. If possible, measure the drop in water level the next day.
- 6. Determine drop in water level per hour. If water level in the hole drops, more than 1 inch per hour, it is well drained and suitable for planting.

Turf Seed Blend Table				
Botanical Name	Common Name	Percentage in Mix		
Festuca arundinacea	Tall Fescue	70%		
Festuca rubra	Creeping Red Fescue	15%		
Poa pratensis	Kentucky Bluegrass	15%		

#### ~~~~~~~~ /1 Plant Schedule\* 4

(ey		Botanical Name	Common Namo	Size	Notes
HADE TI		Botanical Name	Common Name	Size	Inotes
A		Linia da salas a tulia fa un LA un alali	Arnold Tulin Poplar	1.5".0 %	Single truple well branched
	3	Liriodendron tulipifera 'Arnold'	Arnold Tulip Poplar		Single trunk; well-branched
S	1	Nyssa sylvatica 'Wildfire'	Black Tupelo		Single trunk; well-branched
QB	1 0	Quercus bicolor	Swamp White Oak	<del> </del>	Single trunk; well-branched
QL	2	Quercus lyrata	Overcup Oak	1.5" Cal.	Single trunk; well-branched
	EEN TREES	I	Te	Lva en i	Is not a second
xA	3	Ilex × attenuata 'Fosteri'	Foster Holly		Full-to-ground; well-branched
/G	4	Magnolia grandiflora 'Bracken's Brown Beauty'	Bracken's Brown Beauty Magnolia		Full-to-ground; well-branched
G	4	Thuja 'Green Giant'	Green Giant Arborvitae	Min. 5 Hgt.	Full-to-ground; well-branched
	ENTAL TRE				
4xG	3	Amelanchier × grandiflora 'Autumn Brilliance'	Autumn Brilliance Serviceberry		Single trunk; well-branched
CV	3	Chionanthus virginicus	Fringe Tree		Multi-trunk; well-branched
CVW	4	Crataegus viridis 'Winter King'	Winter King Hawthorn		Single trunk; well-branched
.xF	10	Lagerstroemia indica x fauriei 'Tonto'	Tonto Crape Myrtle	Min. 5' Hgt.	Multi-trunk; well-branched
HRUBS					
SxG	14	Buxus x 'Green Velvet'	Green Velvet Boxwood	3 Gal.	3' o.c. spacing
CJN	13	Cryptomeria japonica 'Globosa Nana'	Dwarf Japanese Cedar	3 Gal.	3' o.c. spacing; dwarf variety
G _	20	Ilex glabra 'Shamrock'	Inkberry Holly	3 Gal.	3' o.c. spacing
VI	19	Itea virginica 'Henry's Garnet'	Virginia Sweetspire	3 Gal.	4' o.c. spacing
<u> </u>	11	Prunus laurocerasus 'Schipkaensis'	Schip Laurel	3 Gal.	4' o.c. spacing
RA	59	Rhus aromatica 'Gro-Low'	Gro-Low Sumac	3 Gal.	See plan for spacing; dwarf variety
ΧM	16	Taxus x media 'Densiformis'	Densiformis Yew	3 Gal.	5' o.c. spacing
DRNAM	ENTAL GRA	ASSES			
S	40	Eragrostis spectabilis	Purple Lovegrass	Quart	18" o.c. spacing
Н	25	Sporobolus heterolepis	Prairie Dropseed	Quart	See plan for spacing
ERENNI	ALS				
λΗ	16	Amsonia hubrichtii	Arkansas Blue Star	1 Gal.	30" o.c. spacing
:P	40	Echinacea purpurea	Purple Coneflower	4" Pot	18" o.c. spacing
С	16	Juniperus conferta 'Blue Pacific'	Shore Juniper	1 Gal.	See plan for spacing
PS .		Phlox subulata 'Emerald Blue'	Moss Phlox	<del> </del>	24" o.c. spacing
0		Symphyotrichum oblongifolium 'Raydon's Favorite'	Raydon's Favorite Aster	1 Gal.	30" o.c. spacing
URF / M	EADOW S				<u> </u>
	1,325		Meadow Seed Mix	SF	See Sheet L201 for seed blend
OD		Festuca spp.	Fescue Grass	SF	Sodded turf grass
		ENDMENTS***			
	16	Compost		Cu. Yd.	Approx. 2" depth; install compost for shrub beds only
		Double-Shredded Hardwood Mulch			Approx. 3" depth

#### \*All proposed substitutions must be approved by the Landscape Architect.

## Know what's below. Call before you dig.



P.O. Box 2961 Cleveland, TN 37320 229.326.1179 | philip@shippeyla.com

All drawings and written material contained hereir constitute the original work of Shippey Landscape rchitecture and may not be reproduced, used andscape Architecture, © 2023 Shippe



02/17/2023 1. Planning Comments 02/17/2023

Sheet Name

Planting Notes & Plant Schedule

Sheet Number

3-C-23-UR

Revised: 2/20/2023

#### Seeding Notes

- 1. Field verify areas to receive seed and modify order quantity as necessary.
- 2. Site Preparation: Eradicate exotic invasive plant material by having a licensed spray technician apply an approved herbicide. Good pre-seeding weed control may require repeated spraying at least two weeks apart.
- 3. See Civil Engineer's plans for grading. Finer grading and shaping may be necessary to achieve a smoother, more regular surface for receiving seed. 4. The Contractor shall ensure that all grades will permit safe and efficient use of equipment during
- seedbed preparation, seeding, strawing, and maintenance of vegetation. 5. Loosely grade the topsoil in order to create a non-compacted growth medium prior to spreading
- the seed. Roto-tilling of areas to receive seed is required prior to sowing seed. 6. Evenly spread a thin layer straw mulch to all seeded areas after sowing seed or use hydroseed fiber mulch.
- 7. For areas with slope greater than 3:1, final tracking should be perpendicular to the slope to help reduce erosion, keep seeds in place, and to retain consistent soil moisture for seed germination.
- 8. Concentrations of water flows that could cause soil erosion should be diverted to a safe outlet. Diversions and other treatment practices must conform to the appropriate standards and
- specifications of the Tennessee Erosion and Sediment Control (TDEC) Handbook. 9. The Contractor shall comply with TDEC erosion control requirements throughout the establishment of the seeded areas.
- 10. Maintenance: The Contractor shall observe the growth of the seeded species and eliminate invasive exotic vegetation until final acceptance.
- 11. Protect and care for seeded areas, including watering when needed, until final acceptance. This includes repaired areas and any areas receiving supplemental applications of seed.
- 12. Seed all areas as shown on the plans.
- 13. Protect and care for seeded areas, including watering when needed, until final acceptance. This includes repaired areas as well as any area receiving supplemental applications of seed.

- 14. Seed any left over, disturbed areas following construction with turf seed. See table below for turf seed blend.
- 15. Source meadow seed blend as provided below.

Meadow Seed Source: Roundstone Native Seed, LLC Address: 99764 Raider Hollow Road, Upton, Ky. 42784 Phone: (888)531.2353

Seed Mix: Southern Wetland Meadow Mix Item Number: **Mix 129** 

Source seed as shown at the website listed under the following URL:

https://roundstoneseed.com/wetland-mixes/1034-wetland-meadow-mix.html

<sup>\*\*</sup>Contractor shall verify turf and meadow seed mix quantities needed.

<sup>\*\*\*</sup>Contractor shall verify compost and mulch quantities needed.

H9720200 智强 MUUBY GOROHOON Sprouse TOAST Scribe To 1993/20212 2: property 1202170419 of 1973/3 4rozen cuendand C. Revienie Alamingen ar

#### **KEYNOTES:**

- 1. ROOF DRAINS BELOW SIDEWALK TO STORM SEWER NOTE: EXPELL WATER UNDER SIDEWALK TO CURB - NOT ONTO WALK.
- 2. NEW PANELBOARD(S). 3. DRIVE THRU WINDOW.
- 4. TACTILE ALUMINUM EXIT SIGNAGE IN COMPLIANCE WITH SECTION 1011.3 IBC 2006 SURFACE MOUNTED TO DOOR.
- 5. TACTILE ALUMINUM RESTROOM SIGNAGE IN COMPLIANCE WITH
- SECTION 1110.1 IBC 2006 SURFACE MOUNTED TO DRYWALL. 6. PROVIDE 3' CLEAR ACCESSIBLE EGRESS PATH.
- 7. CONTRACTOR TO CONFIRM LOCATION OF THE CENTER SERVICE ISLAND WITH ARCHITECT BEFORE ROUGH-IN OF PLUMBING. 8. ROOF STRUCTURE WITH CLEAR ANODIZED ALUMINUM FASCIA WITH 3 CONTINUOUS BANDS OF NEON TUBING AND HARDIE
- REVEAL PANEL [7/16"] SOFFIT PAINTED WHITE 9. INSTALL CORNER GUARDS, TYP. 10. PROVIDE HOT AND COLD WATER HOSE BIB ON WALL BEHIND AND
- ADJACENT TO CUSTARD MACHINES. 11. FIRE EXTINGUISHER AND CABINET - SEE 4/A701 12. COORDINATE INSTALLTION OF WALK-IN COOLER AND FREEZER W/
- SUPPLIER 13. EFCO 403 STOREFRONT OR EQUIVALENT - REINFORCE AS
- REQUIRED BY MFG. W/ 1" INSULATED GLAZING 14. EFCO 5500 CURTAIN WALL SYSTEM OR EQUIVALENT WITH 1 " INSULATED GLAZING
- 15. CLEAR OVER CLEAR 1" INSULATED GLAZING SEE GLAZING
- SPECS ON SHEET A701. 16. OCCUPANCY LOAD SIGNAGE IN COMPLIANCE WITH SECTION
- 1004.3 IBC 2003 SURFACE MOUNTED ABOVE DOOR.
- 17. CORNER TO BE BUTT-GLAZED WITH A 45 DEGREE MULLION
- 18. CUSTARD MACHINES TO STRADDLE FLOOR SINKS 19. ANDY'S MENU AND POSTER SIGNAGE BY OTHERS - VERIFY
- INSTALLED LOCATION W/ OWNER 20. EXTERIOR UPLIGHTING MOUNTED TO MULLION PER
- SPECIFICATIONS 21. MAINTAIN A MINIMUM OF 10" CLEAR ON OPERABLE SIDE OF WALK-IN COOLER AND FREEZER - COORDINATE DETAILING W/ MFG. 22. TRASH / RECYCLING PER OWNER
- 23. ALL EXPOSED DUCTWORK TO BE PAINTED WHITE TO MATCH GWB CEILING
- 24. 60 MIL WHITE TPO MECHANICALLY FASTENED WITH 1" RIGID INSULATION.
- 25. PROVIDE SOLID BLOCKING FOR ALL SHELVES & WALL MOUNTED EQUIPMENT. SEE A203 FOR LOCATIONS
- 26. COLUMNS PER STRUCTURAL
- 27. BRICK VENEER PER WALL SECTION 28. PERIMETER NEON LIGHTING ON EXTENTS OF ALUMINUM FASCIA
- BY OWNER 29. SQUARE CUT ROOF EDGE
- 30. SITE WORK PER CIVIL PLANS AND SPECIFICATIONS
- 31. COMPOSITE SLATS ON GALVANIZED TUBE STEEL FRAME 32. QUIKSERV PRODUCTS INC. SLIDING WINDOWS. SELF CLOSING SC-4030 AT WALK-UP PATIO WINDOWS. FULLY AUTOMATIC 4035E
- 33. CAP AND SILL FLASHING AT TOP DATUM OF MASONRY VENEER AND FREESTANDING WALL, TYP.
- 34. FOUNDATION PER STRUCTURAL

AT DRIVE THRU WINDOW.

- 35. WALL TYPE PER PLAN 36. DUCTWORK LOCATION AND SIZING PER MEP
- 37. ROOF CONSTRUCTION 60 MIL WHITE TPO ROOFING MECHANICALLY FASTENED ON 1 " RIGID INSULATION OVER TJI'S PER STRUCTURAL WITH OPEN CELL INSULATION - MINIMUM OF
- 38. WHITE SPANDREL GLAZING ALL SPANDREL GLASS TO BE WHITE
- U.O.N. 39. PREFINISHED METAL BOX GUTTER
- 40. PRE-FINISHED METAL PARAPET CAP FLASHING 41. 1"x3" T+G COMPOSITE SIDING. BASIS OF DESIGN: TIMBERTECH
- PORCH COLLECTION, MAHOGANY 42. JAMES HARDIE - 5/16" HARDIE PANEL® COLOR PLUS® EXTERIOR
- FIBER CEMENT VERTICAL SIDING 4' x 10' SECTIONS SMOOTH FINISH - COLOR: LIGHT MIST; ON 3/4" BATTENS
- 43. CASED OPENING FOR WALK-IN COOLER ACCESS 44. HARDIE REVEAL PANEL [7/16"] SOFFIT PAINTED WHITE
- 45. 5" DIAMETER DOWNSPOUT CONNECTED TO STORM SEWER PER CIVIL PLANS
- 46. ANDY'S FROZEN CUSTARD NEON CONE SIGN "MADE FRESH EVERY HOUR" - LOCATED INSIDE STORE IN FRONT OF STOREFORNT GLAZING - SUSPEND FROM HORIZONTAL MULLION
- AND CONCEAL POWER SUPPLY ALONG INSIDE FACE OF MULLION 47. ANDY'S FROZEN CUSTARD SPRECHER ROOT BEER NEON SIGN -LOCATED INSIDE STORE IN FRONT OF STOREFORNT GLAZING -SUSPEND FROM HORIZONTAL MULLION AND CONCEAL POWER
- SUPPLY ALONG INSIDE FACE OF MULLION 48. STEEL PIPE BOLLARD - 4" DIAMETER SCHEDULE 40 STEEL PIPE - 4 ABOVE GRADE W/ 2' CORE BELOW GRADE
- 49. ELECTRIC STUB

#### **PARTITION LEGEND:**

**NEW INTERIOR PARTITION** 2 x 6 WOOD STUDS A-1: 5/8" GWB BOTH SIDES **A-2**: 5/8" GWB ONE SIDE

#### **NEW INTERIOR PARTITION** 2 x 4 WOOD STUDS, 5/8" GWB


**B-2**: 5/8" GWB ONE SIDE 1. DIMS. ARE FROM FACE OF STUD TO FACE OF STUD UNLESS OTHERWISE

B-1: 5/8" GWB BOTH SIDES

- 2. REFER TO A701 FOR NOTES ON WAL TYPE / DETAILING.
- 3. REFER TO FINISH PLAN AND SCHEDULE FOR VARIATIONS TO INTERIOR WALL FINISHES. 4. ALL FOOD AND NON-FOOD
- SURFACES ARE TO BE SMOOTH DURABLE, NON-ABSORBENT, LIGHT IN COLOR AND EASILY CLEANABLE PER LOCAL CITY HEALTH DEPARTMENT REGULATIONS.
- 5. REFER TO INT. ELEV. FOR CONDITIONS WITH TILE AS FIN. WALL SURFACE - PROVIDE 5/8" CONCRETE BACKER BOARD IN LIEU OF G.W.B. 6. BATHROOM WALLS SHOULD BE
- INSUL. WITH SOUND BATT INSUL. TO ACHIEVE AN STC RATING OF 50 7. ALL WALLS CONTAINED WITHIN OR DIRECTLY FACING ROOM 2 - BACK OF HOUSE TO UTILIZE FRP 1 IN LIEU OF

5/8" G.W.B.

3-C-23-UR Revised: 2/20/2023

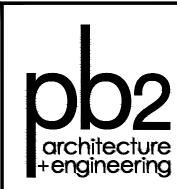

2809 Ajax Avenue Suite 100 Rogers Arkansas 72758 Phone: 479.636.3545

Fax: 479.636.1209

Architect of Record

William Douglas Hurley Tennessee License No. 102100 Firm Disclosure No. 3502






STARD FROZEN CUS

OLIFOL(ED D)/	11440			

ISSUE BLOCK

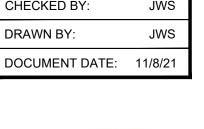




SHEETS BEARING THIS SEAL ARE AUTHENTICATED; RESPONSIBILITY FOR ALL OTHER PLANS, SPECIFICATIONS OR INSTRUMENTS ARE DISCLAIMED

DIMENSIONED PLAN

SHEET: A201

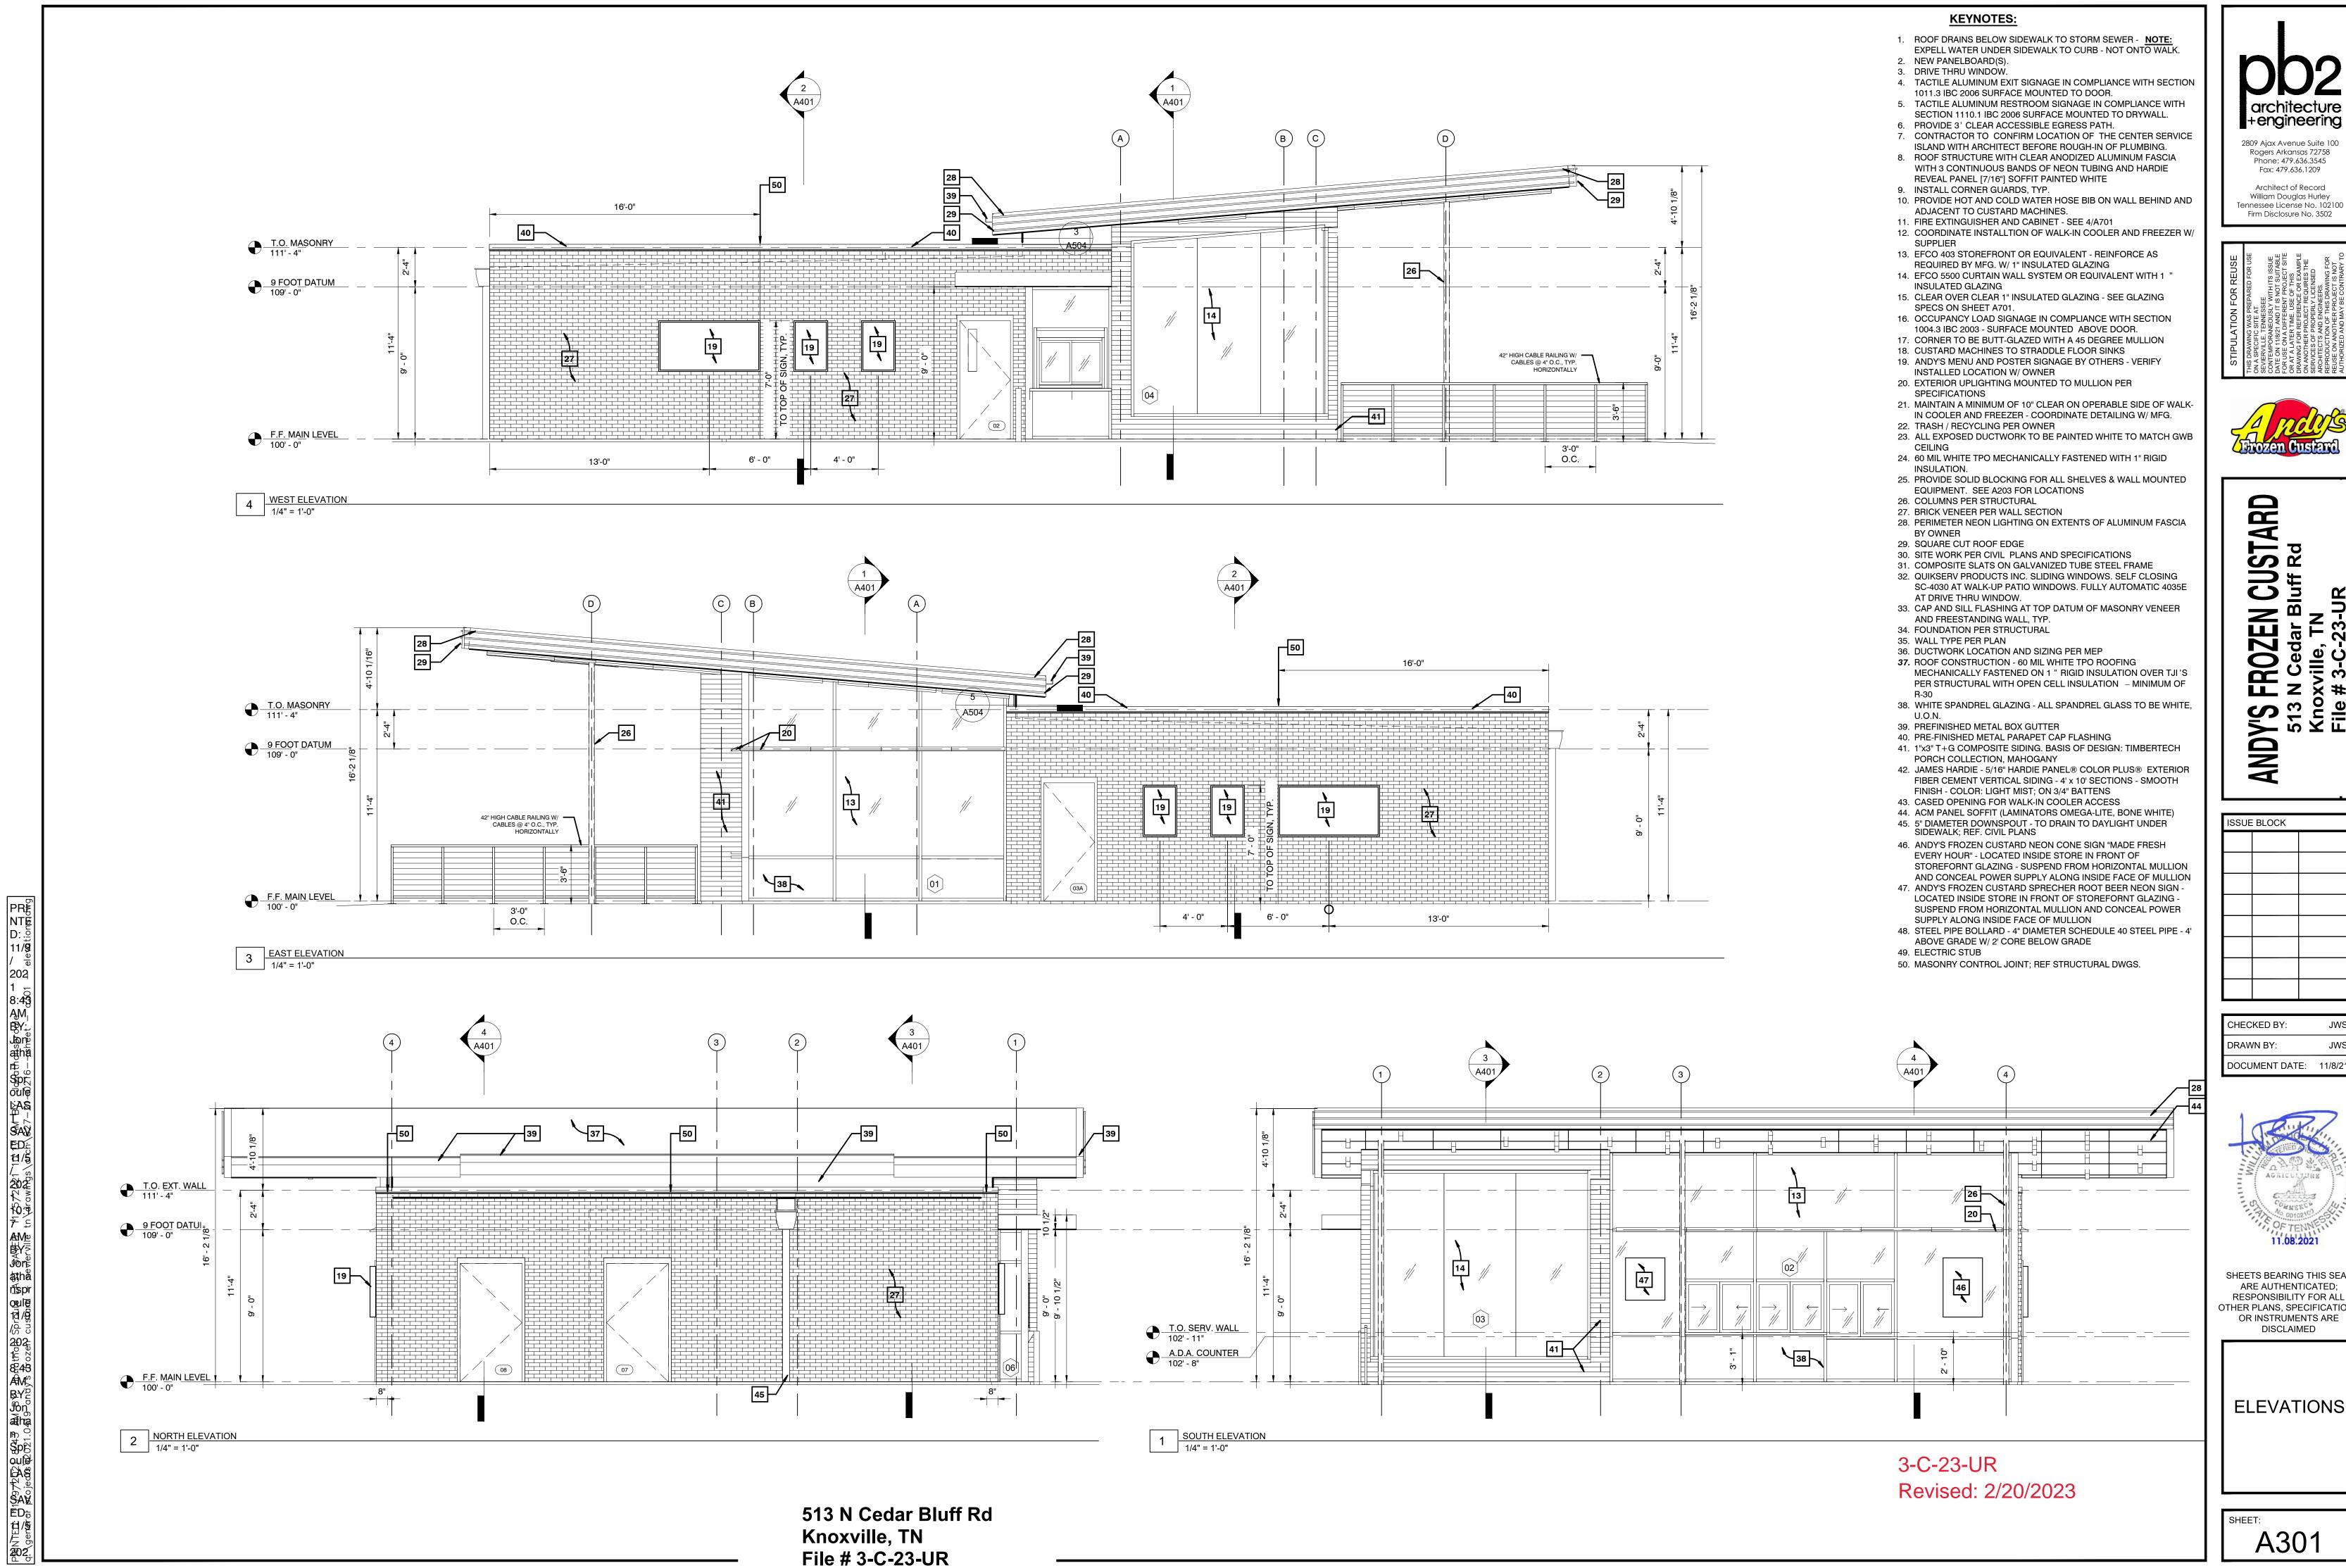

+engineering

2809 Ajax Avenue Suite 100 Rogers Arkansas 72758 Phone: 479.636.3545 Fax: 479.636.1209



CUSTARD Y'S FROZEN CUS 513 N Cedar Bluff F Knoxville, TN File # 3-C-23-UR

OUEOVED DV		114/0		


CHECKED BY JWS DOCUMENT DATE: 11/8/21



SHEETS BEARING THIS SEAL ARE AUTHENTICATED; RESPONSIBILITY FOR ALL OTHER PLANS, SPECIFICATIONS OR INSTRUMENTS ARE DISCLAIMED

**ELEVATIONS** 

A301

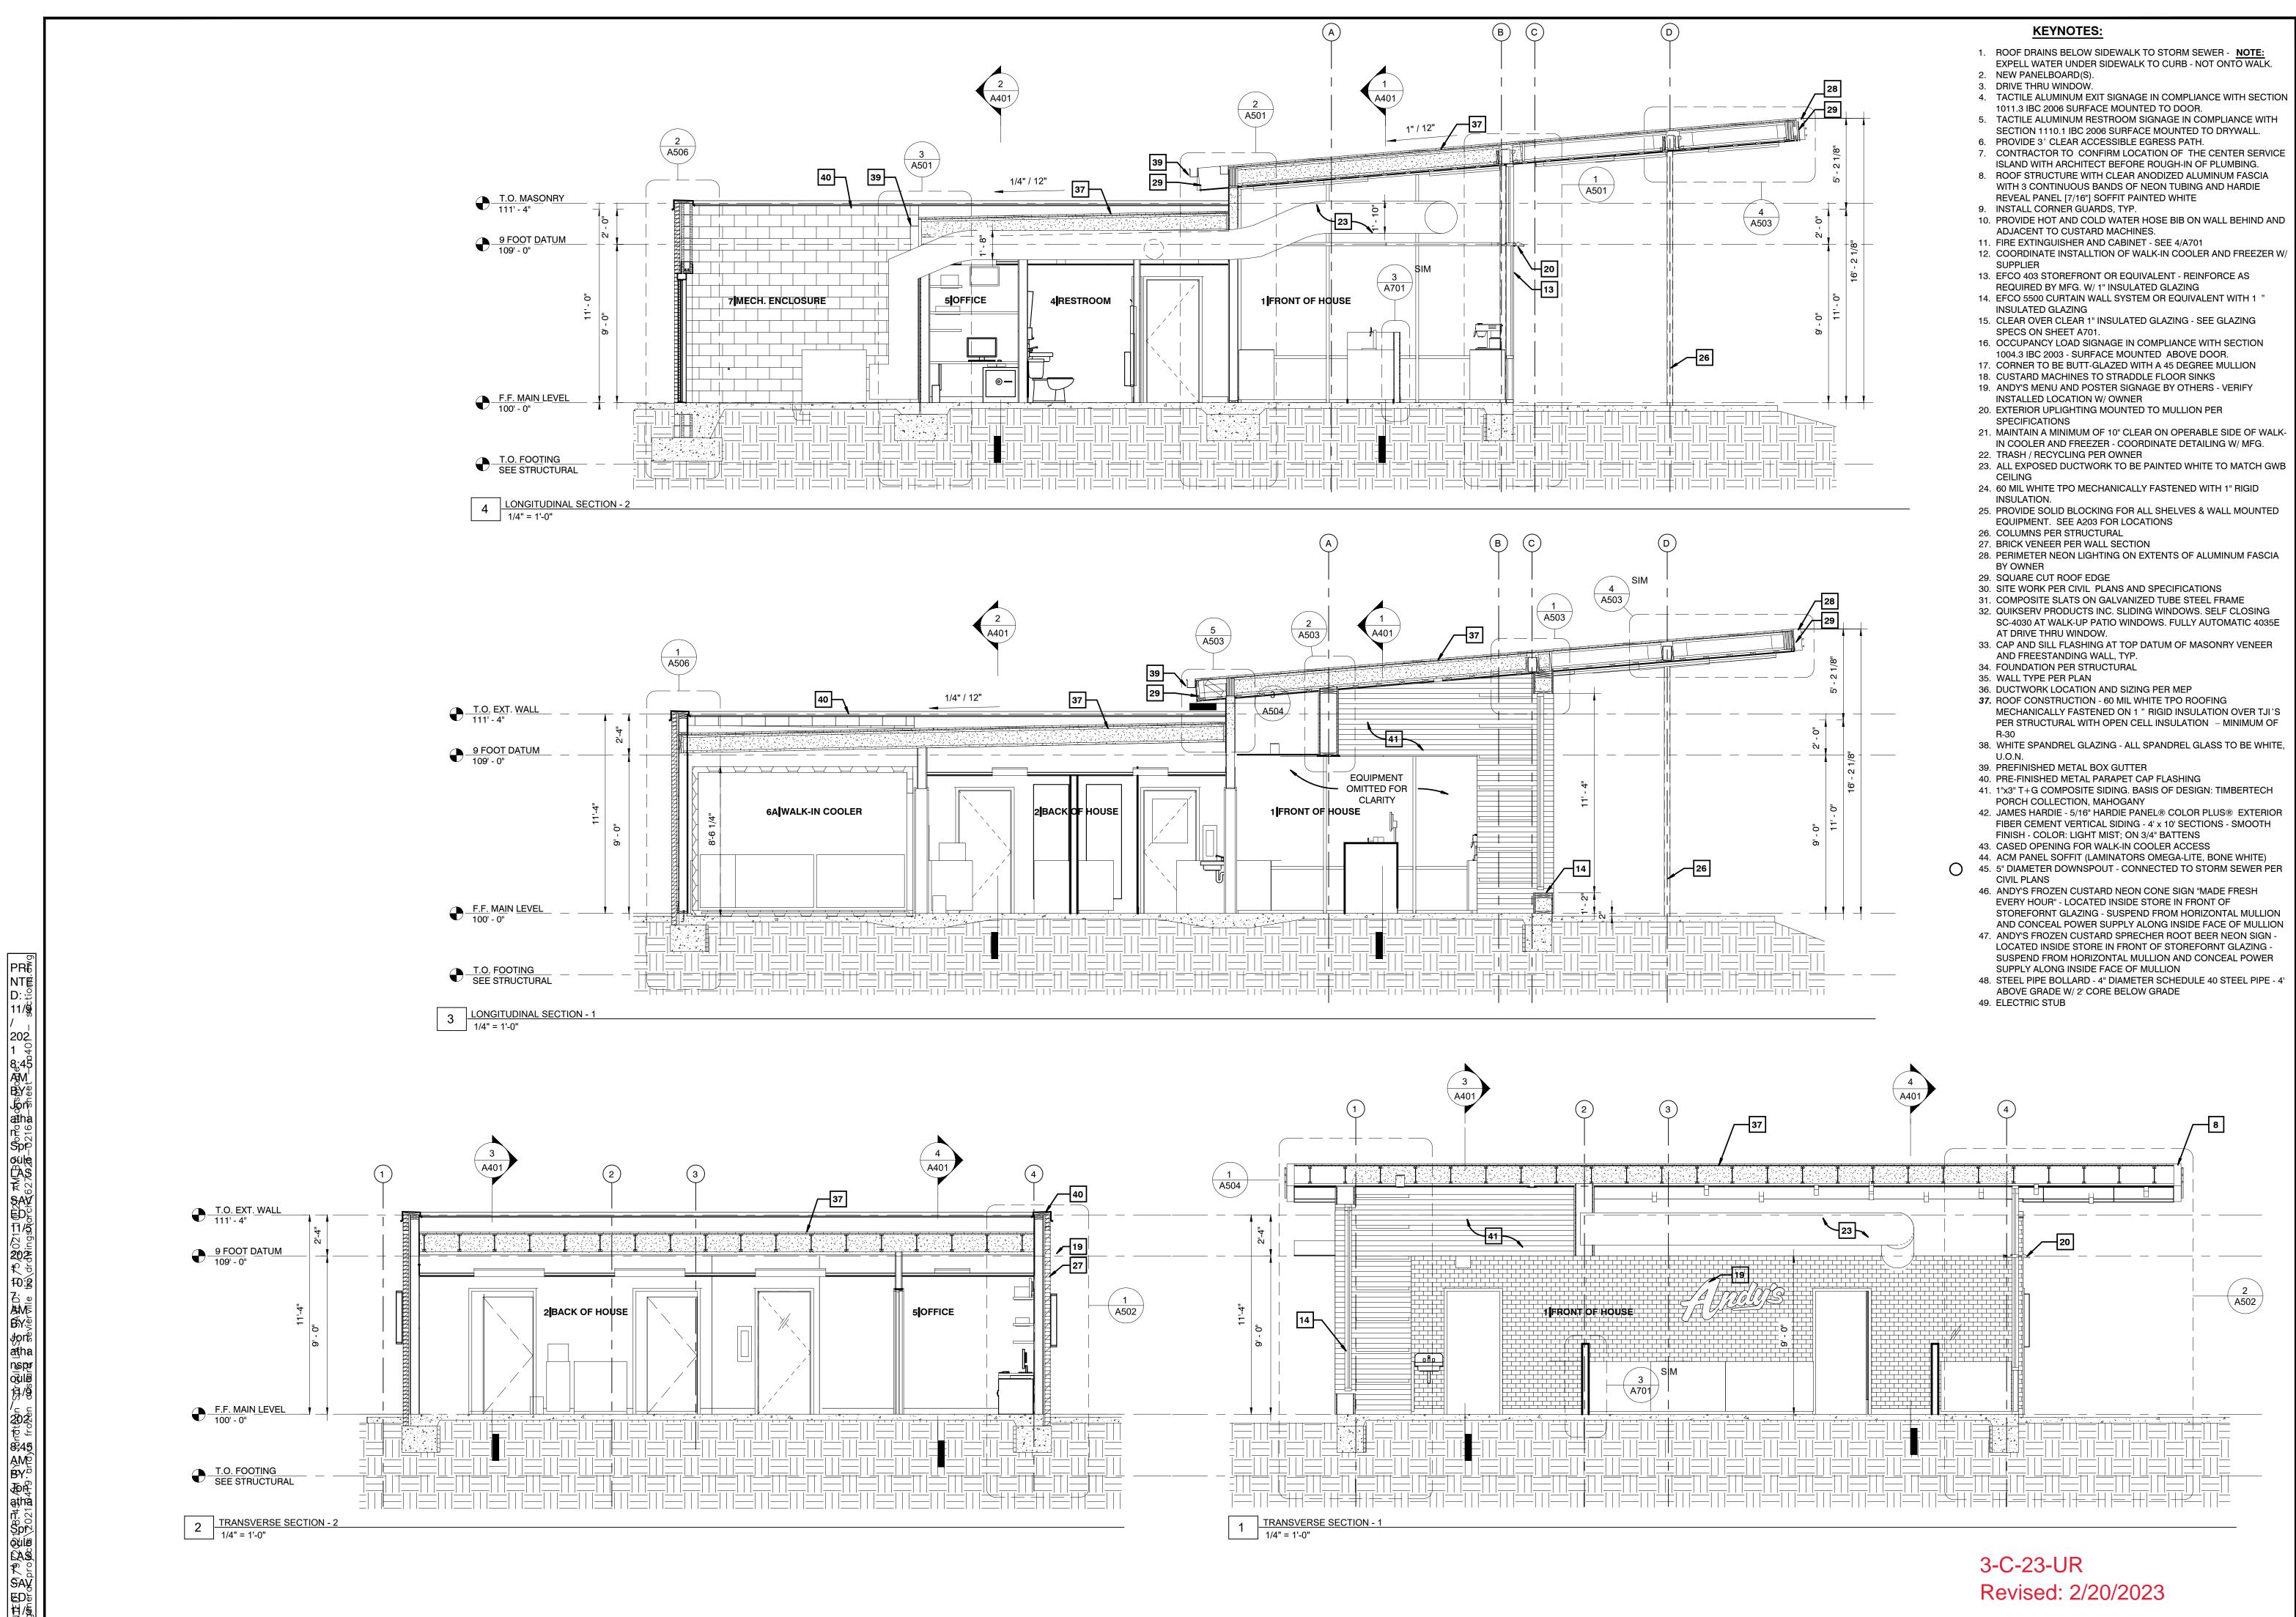

1 TRANSVERSE SECTION - 1
1/4" = 1'-0"

2 TRANSVERSE SECTION - 2
1/4" = 1'-0"

FROZEN CUSTARD

N Cedar Bluff Rd

ANDY'S 513

ISSUE BLOCK

N Cedar Bluf exville, TN # 3-C-23-UR

+engineering

2809 Ajax Avenue Suite 100

Rogers Arkansas 72758

Phone: 479.636.3545

Fax: 479.636.1209

Architect of Record

William Douglas Hurley

Tennessee License No. 102100

Firm Disclosure No. 3502

CHECKED BY: JWS DRAWN BY: DOCUMENT DATE: 11/8/21



SHEETS BEARING THIS SEAL ARE AUTHENTICATED; RESPONSIBILITY FOR ALL OTHER PLANS, SPECIFICATIONS OR INSTRUMENTS ARE DISCLAIMED

**SECTIONS** 

SHEET: A401

3-C-23-UR

Revised: 2/20/2023