



Blankenship & Partners, LLC
Architects and Planners

1112 E. Weisgarber Rd., 2nd Floor, Knoxville, TN 37909

Office: 865.251.2885 Fax: 865.531.7911

Contact Name: William R. Blankenship

Owner:

Contact Name:

Project Name:

Oak Grove Duplex Project

Consultants:

Contact Name:

Contact Name:

© COPYRIGHT Blankenship & Partners, LLC
This drawing is the property of Blankenship & Partners, LLC, and shall not be reproduced in whole or in part. It shall not be used for any other project. This drawing is an instrument of service only and shall be returned to the Architect upon request.

Seal

FOR PRICING NOT FOR CONSTRUCTION

Date: 6-14-23

Drawn By: SN

Checked By: BB

Project Number: 22-xx

Revisions

No. Date:


2 3-21-24

Drawing Title:

Site Plan

Drawing No.:

A0

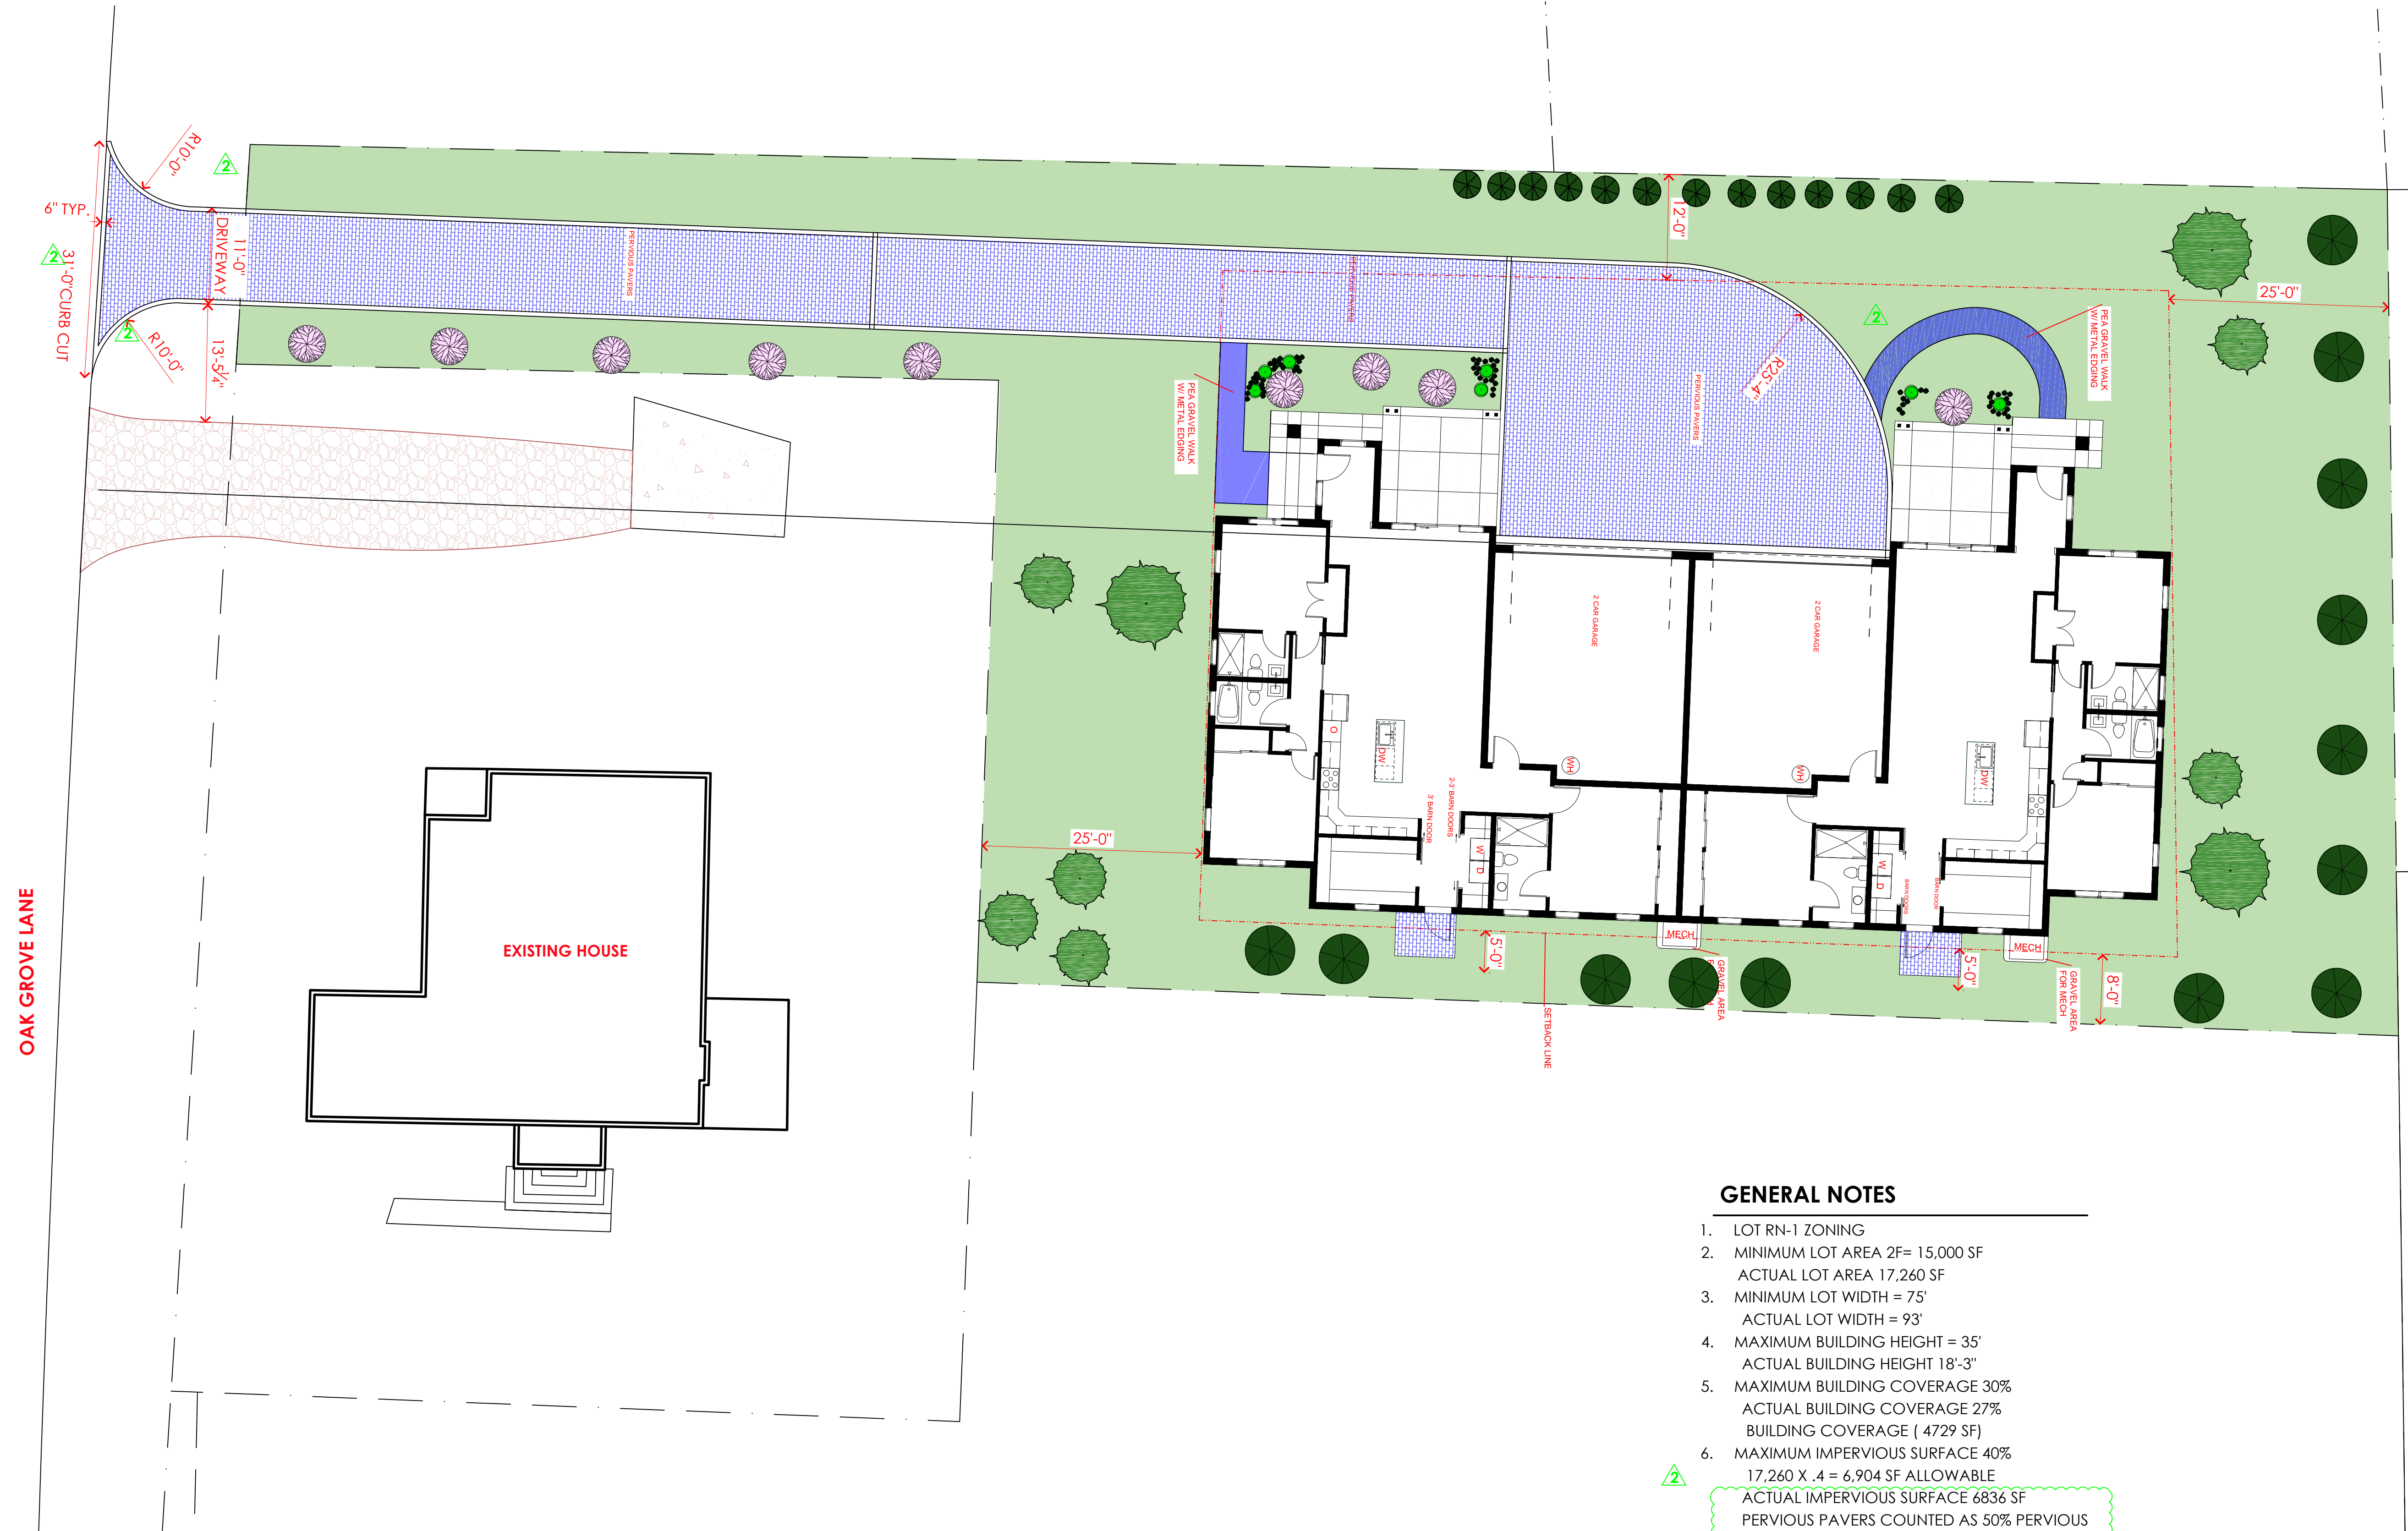

OAK GROVE LANE

N
1
A0
SITE PLAN
Scale: 1" = 10'-0"

GENERAL NOTES

- LOT RN-1 ZONING
- MINIMUM LOT AREA 2F= 15,000 SF
ACTUAL LOT AREA 17,260 SF
- MINIMUM LOT WIDTH = 75'
ACTUAL LOT WIDTH = 93'
- MAXIMUM BUILDING HEIGHT = 35'
ACTUAL BUILDING HEIGHT 18'-3"
- MAXIMUM BUILDING COVERAGE 30%
ACTUAL BUILDING COVERAGE 27%
BUILDING COVERAGE (4729 SF)
- MAXIMUM IMPERVIOUS SURFACE 40%
17,260 X .4 = 6,904 SF ALLOWABLE
ACTUAL IMPERVIOUS SURFACE 6836 SF
PERVIOUS PAVERS COUNTED AS 50% PERVIOUS
2724 SF PERVIOUS PAVERS /2 = 1362 SF
ALL AREA SURFACES = 8198 SF
8198 SF - 1362 SF = 6836 SF

DRIVEWAY REDESIGNED
SHAPE AND WIDTH CHANGED
TO RESPOND TO REVIEW COMMENTS
ENTRANCE TO DRIVEWAY REDESIGNED
TO MEET FIRE DEPARTMENT COMMENT
CURB CUT CHANGED.

4-B-24-SU
3/22/2024



Blankenship & Partners, LLC
Architects and Planners

1112 E. Weisgarber Rd., 2nd Floor, Knoxville, TN 37902

Office: 865.251.2585 Fax: 865.531.7911

Contact Name: William R. Blankenship

Owner:

Contact Name:

Project Name:

Oak Grove Duplex Project

Consultants:

Contact Name:

Contact Name:

© COPYRIGHT Blankenship & Partners, LLC
This drawing is the property of Blankenship & Partners, LLC, and shall not be reproduced in whole or in part. It shall not be used for any other project. This drawing is an instrument of service only and shall be returned to the Architect upon request.

Seal

FOR PRICING NOT FOR CONSTRUCTION

Date: 6-14-23

Drawn By: SN

Checked By: BB

Project Number: 22-xx

Revisions

No. 3-21-24 Date:






△

Drawing Title:

Floor Plan

Drawing No.:


A002.00

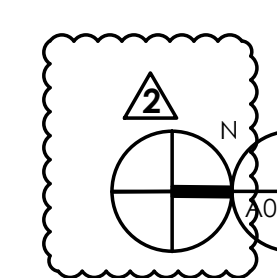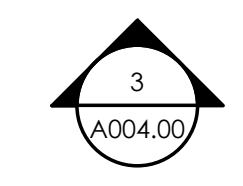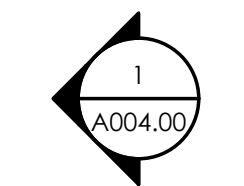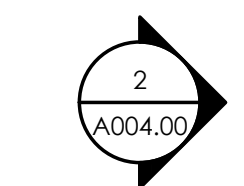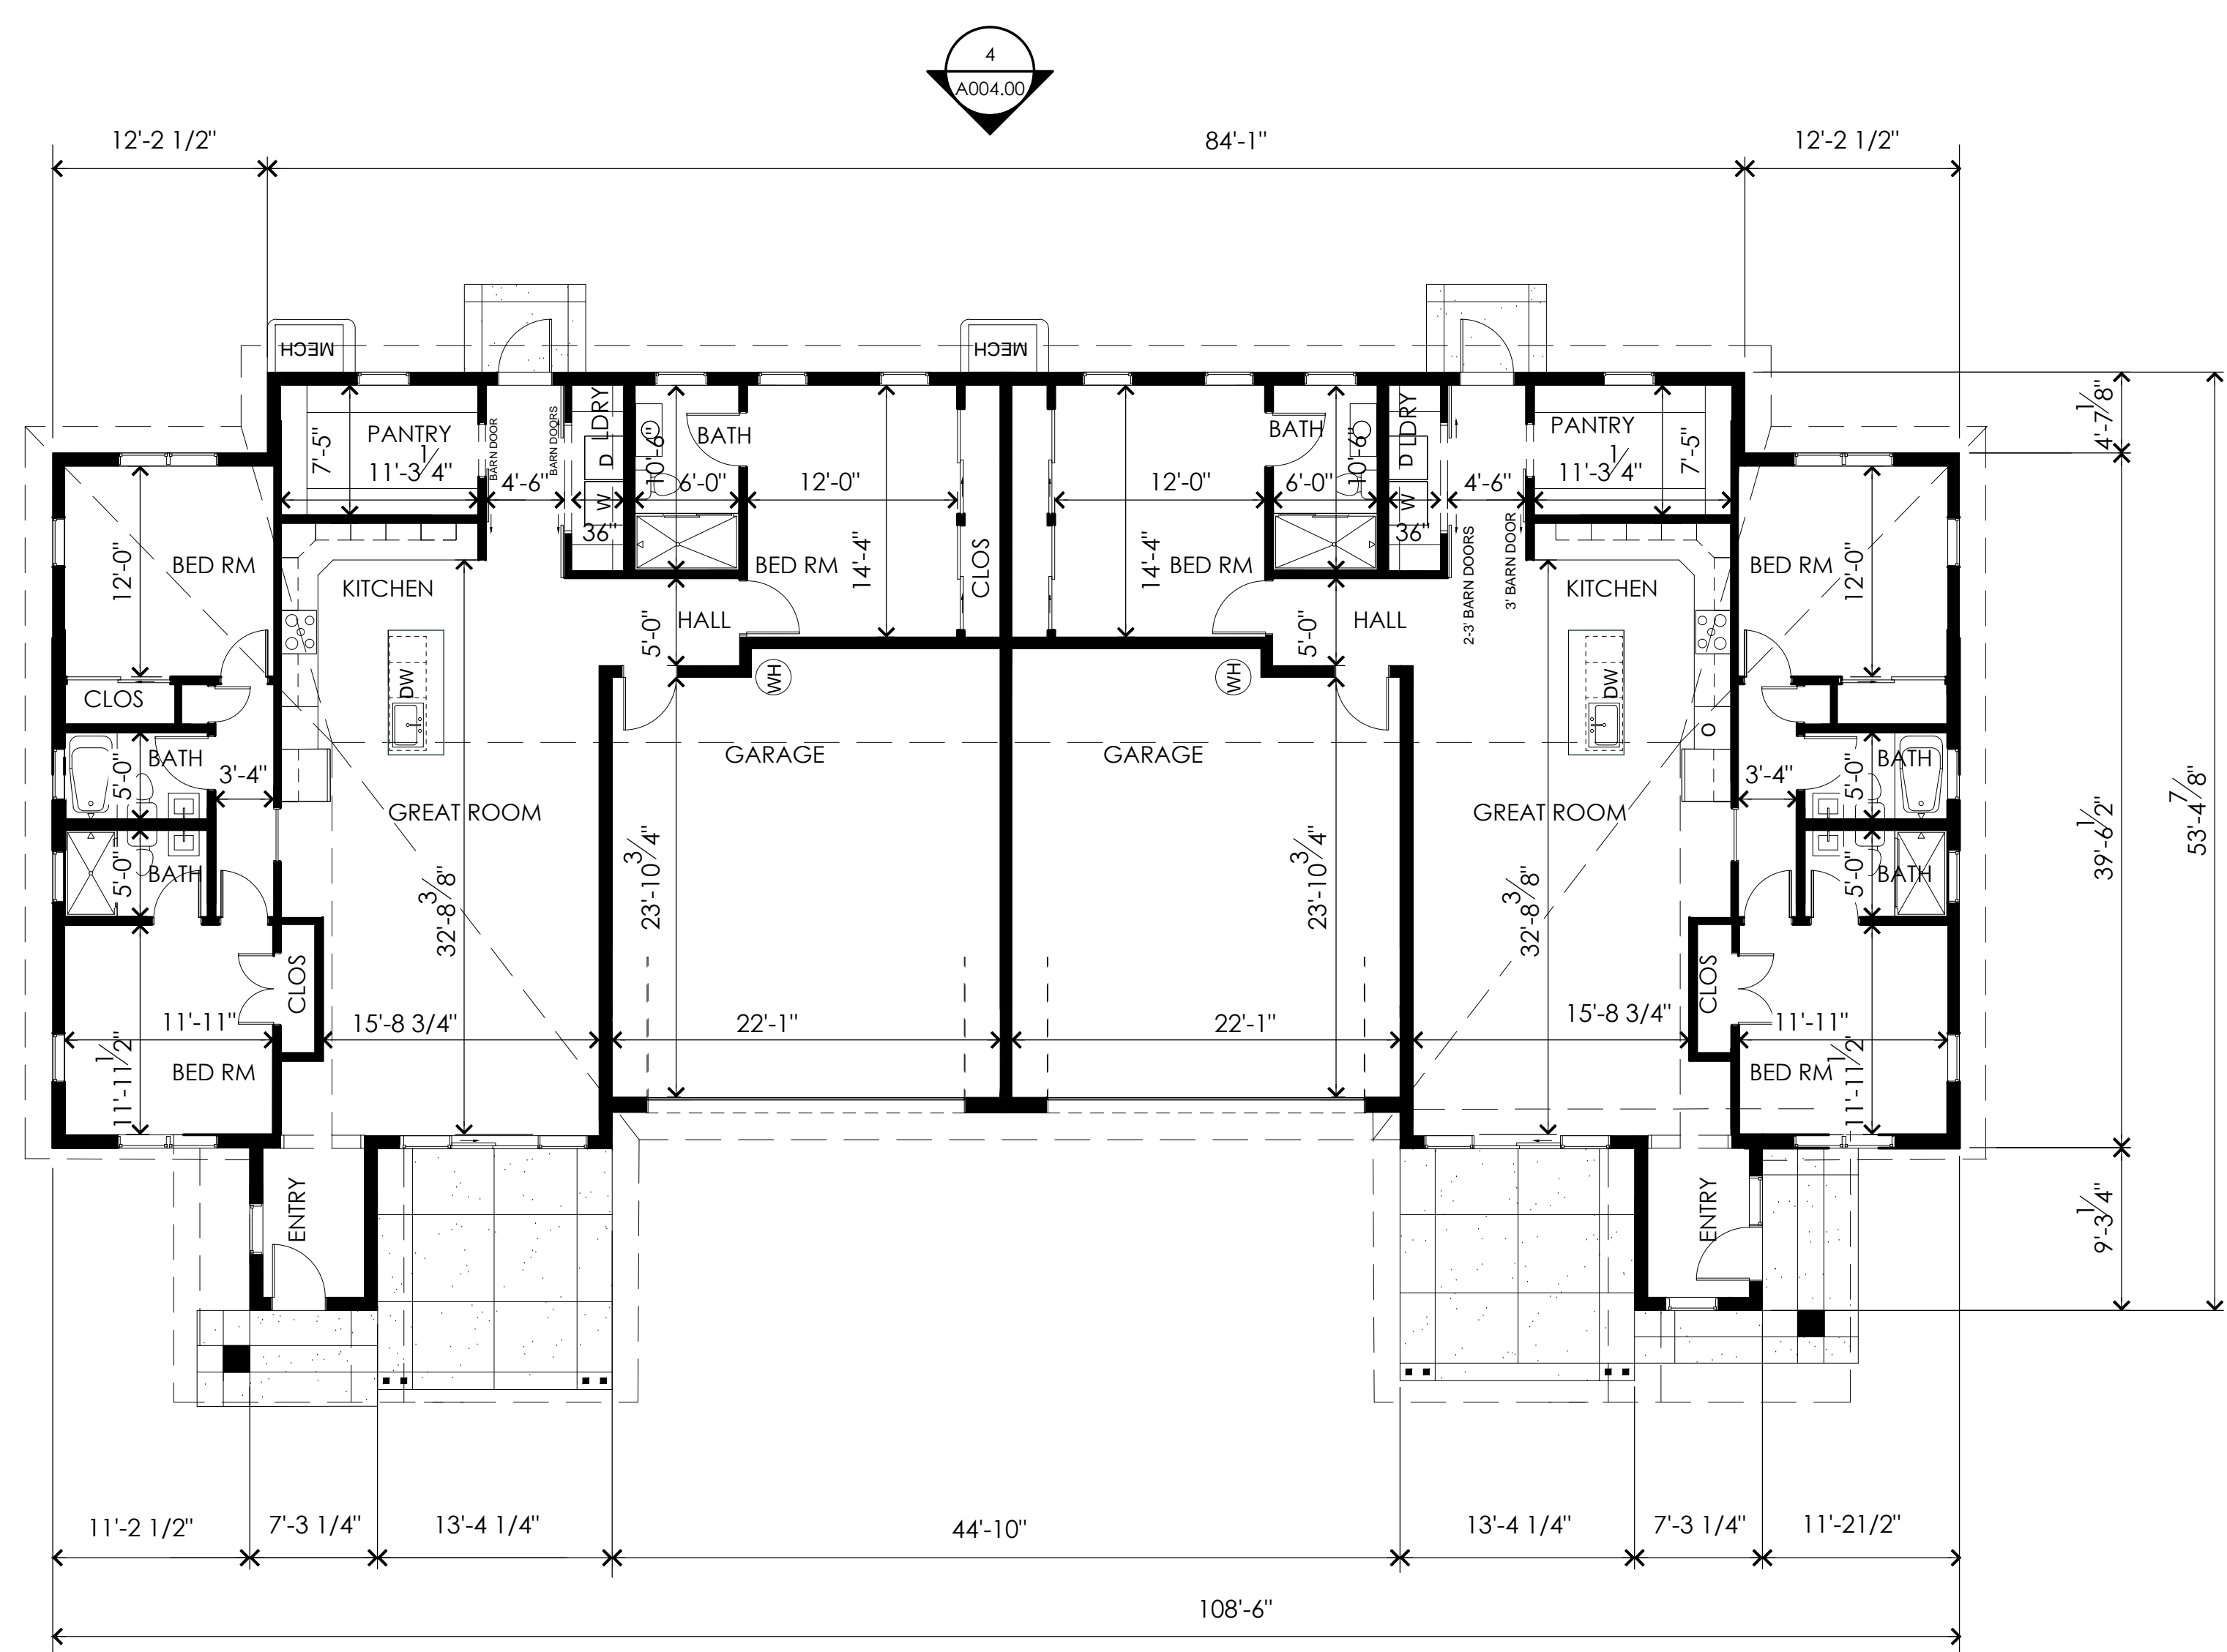

PLAN
Scale: 1/8" = 1'-0"

4-B-24-SU
3/22/2024

NORTH ARROW CHANGED TO CORRECT DIRECTION

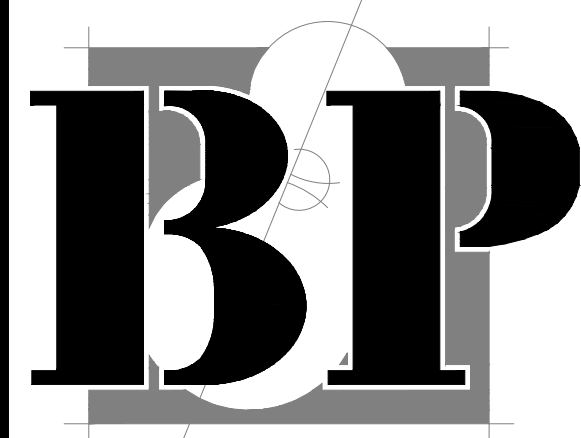

Blankenship & Partners, LLC
Architects and Planners

1112 E. Weisgarber Rd., 2nd Floor, Knoxville, TN 37911
Office: 865.251.2585 Fax: 865.531.7911
Contact Name: William R. Blankenship
Owner:

Contact Name:
Project Name:

Oak Grove Duplex Project

Consultants:

Contact Name:

Contact Name:





© COPYRIGHT Blankenship & Partners, LLC
This drawing is the property of Blankenship & Partners, LLC, and shall not be reproduced in whole or in part. It shall not be used for any other project. This drawing is an instrument of service only and shall be returned to the Architect upon request.

Seal
FOR PRICING NOT FOR CONSTRUCTION

Date: 6-14-23
Drawn By: SN
Checked By: BB
Project Number: 22-xx
Revisions
No. 3-7-24 Date:

Drawing Title:
Elevations

Drawing No.:
A004.00

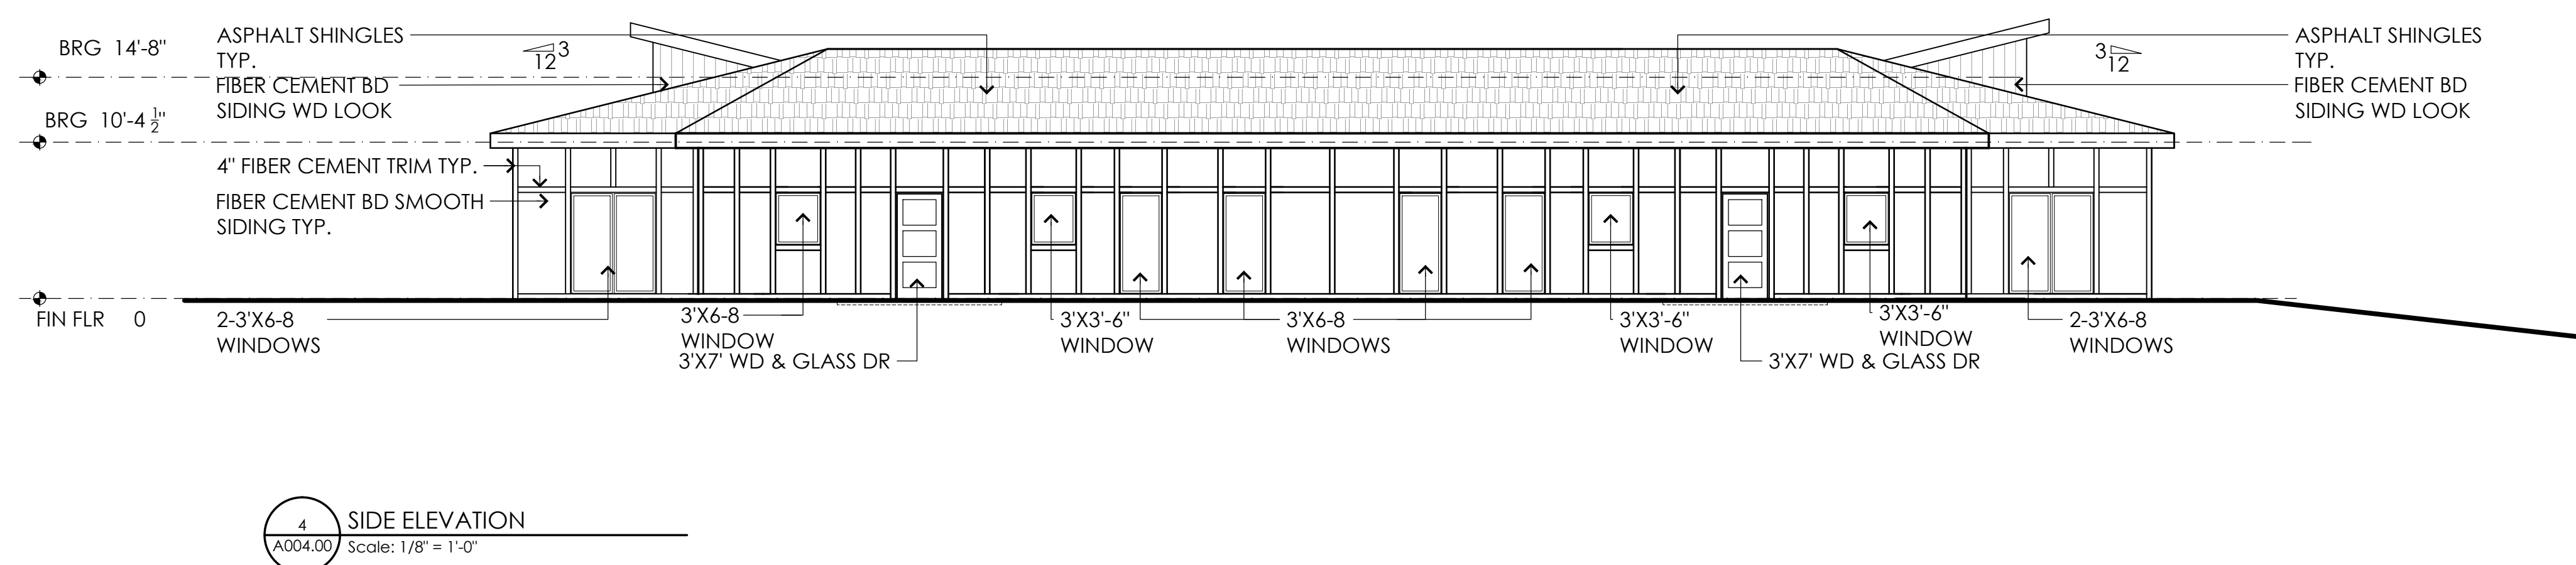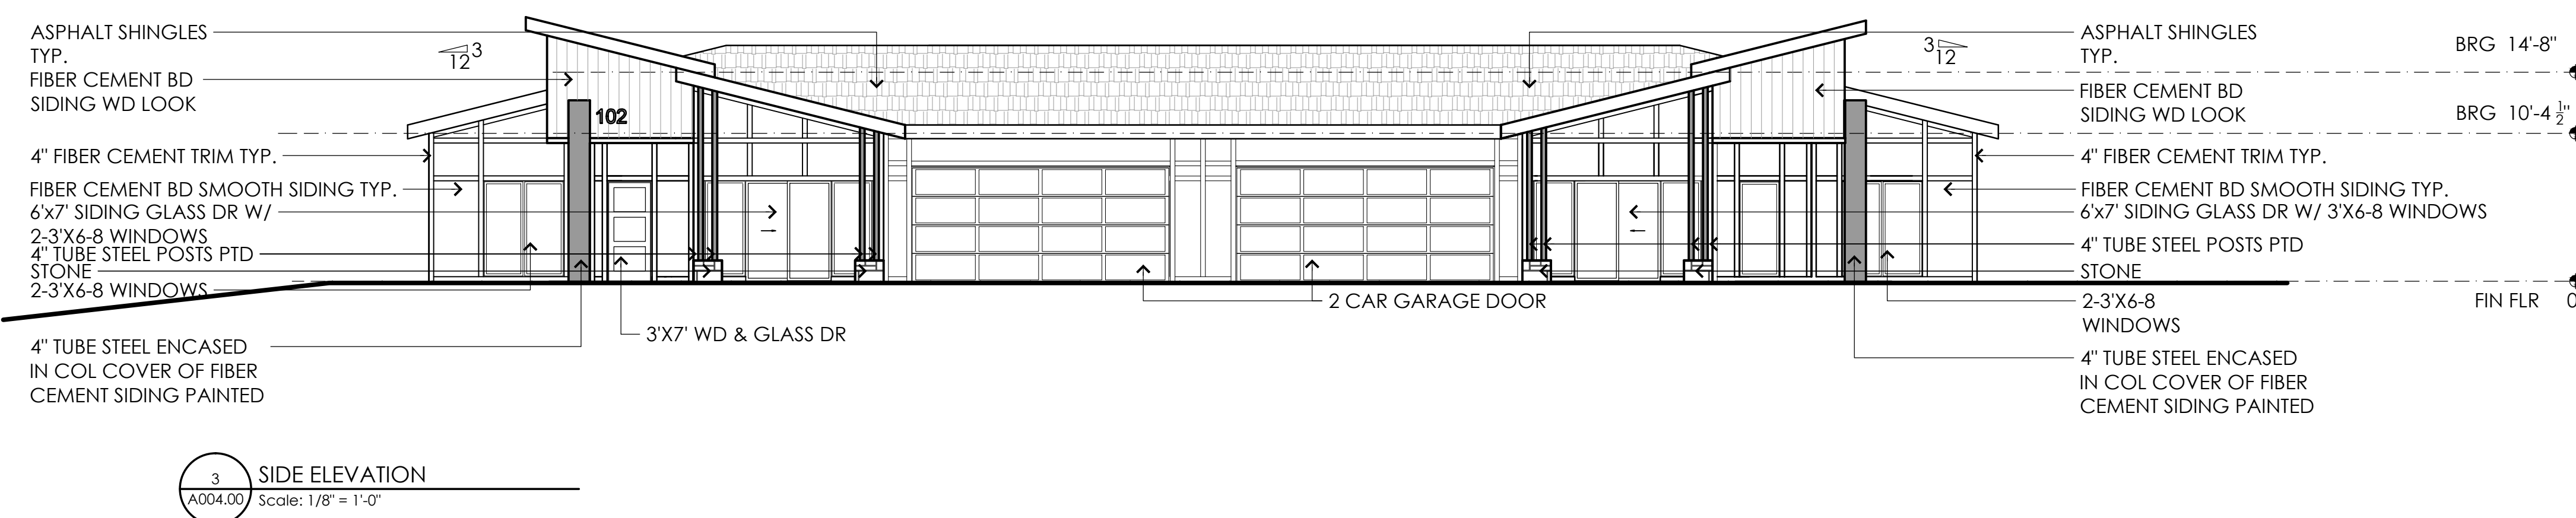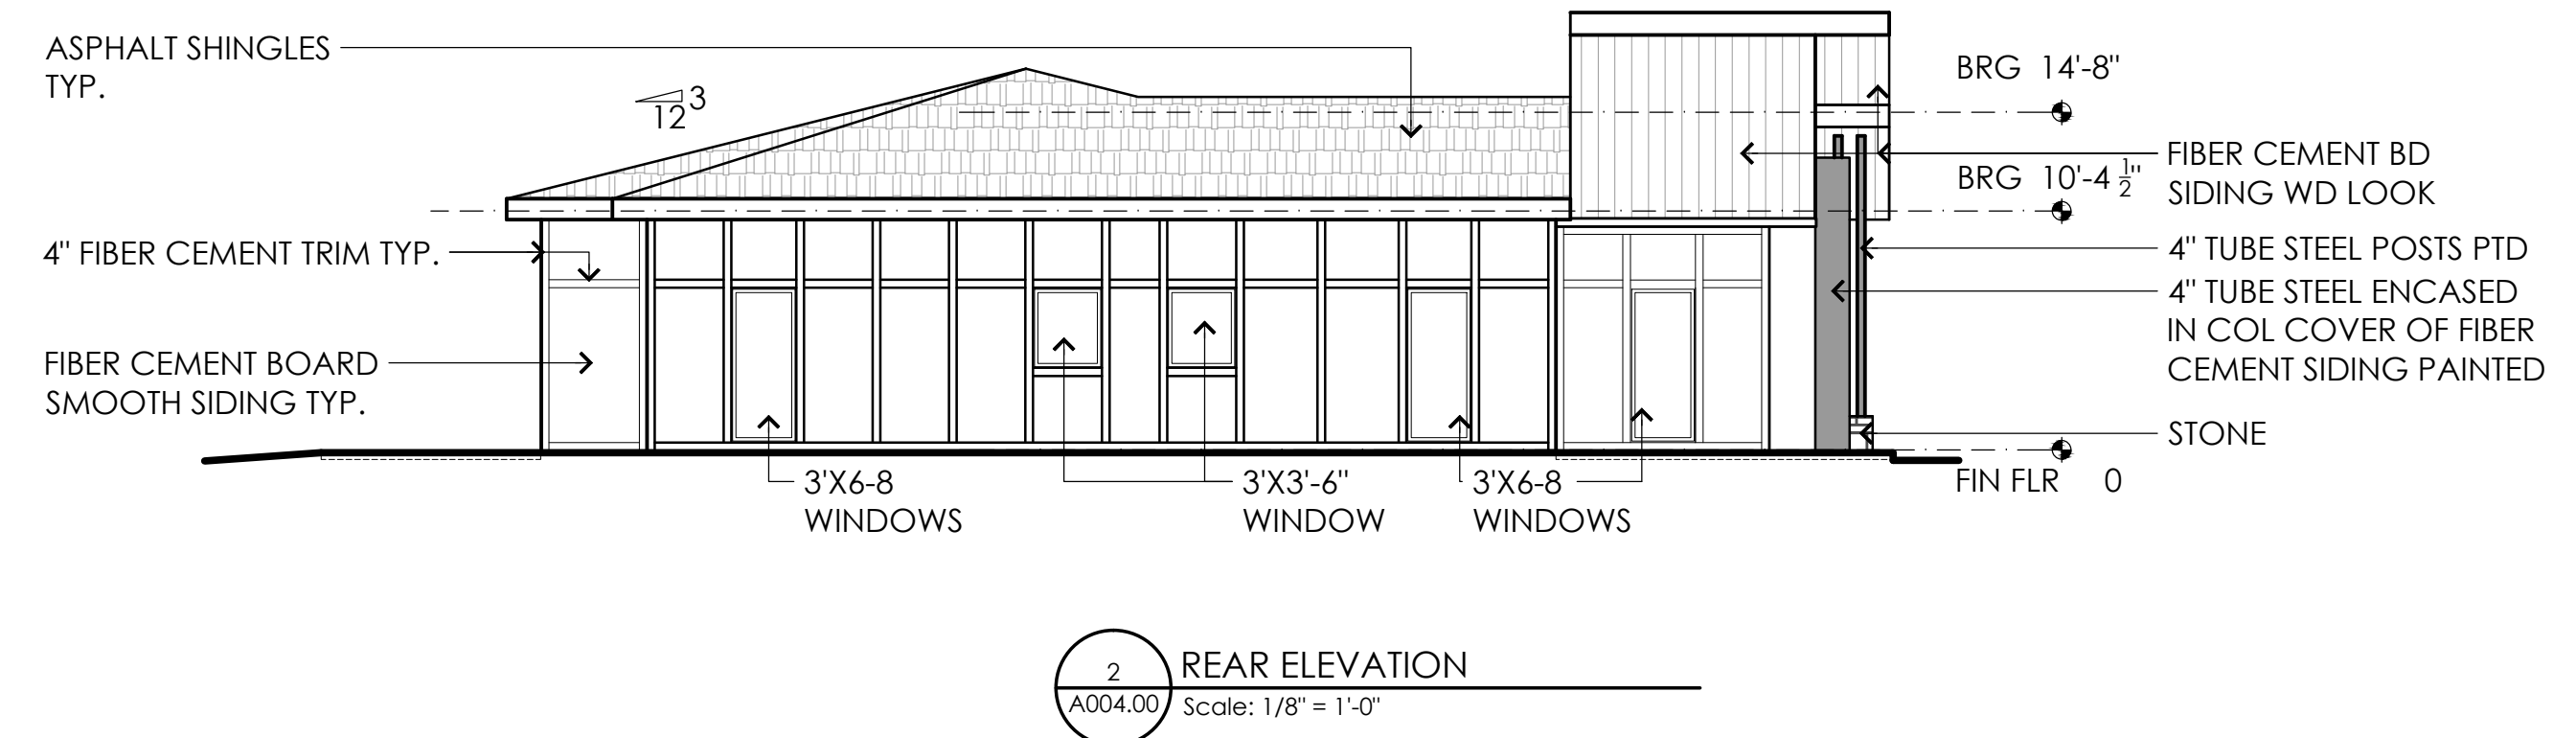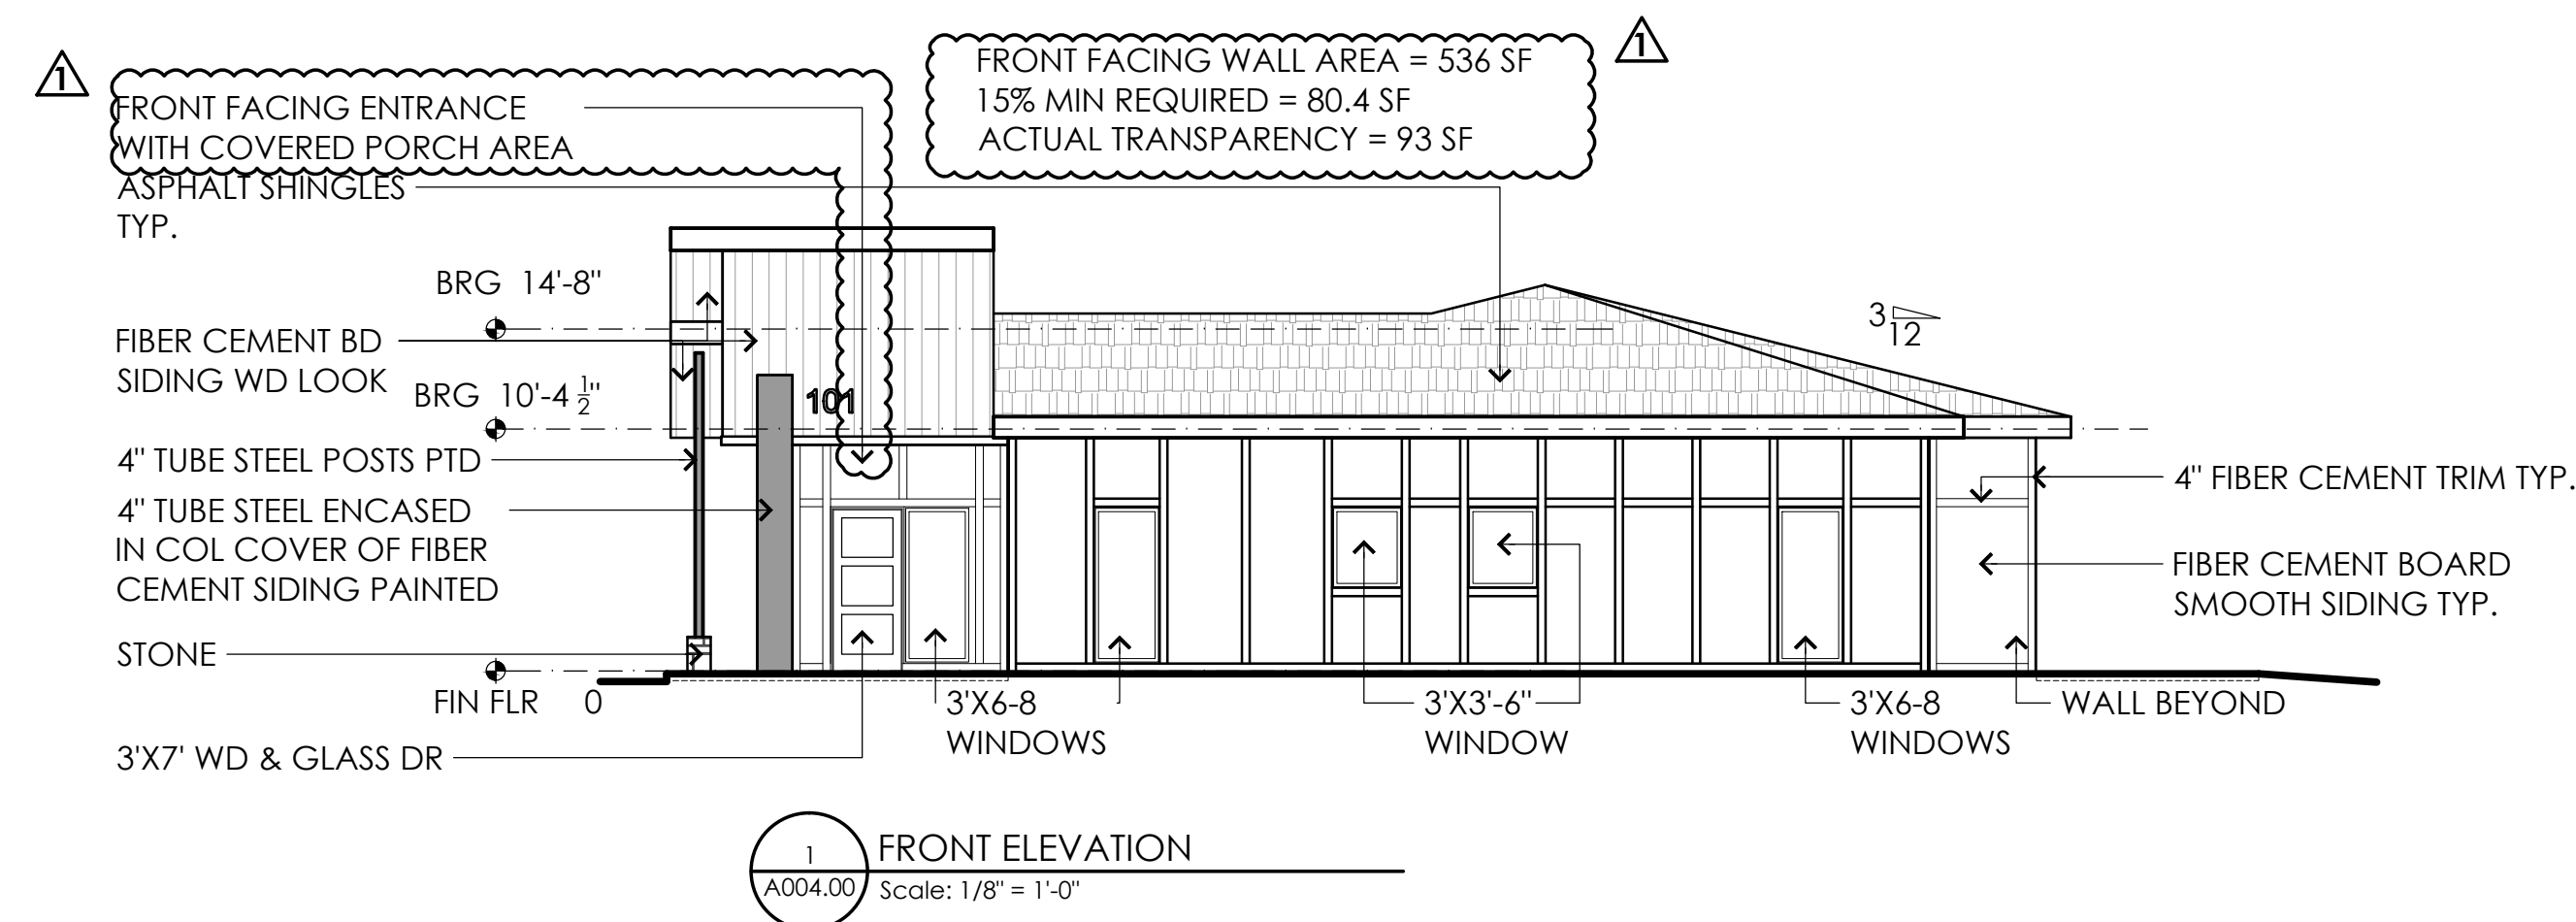

4-B-24-SU
3/7/2024