
B BANNER SIGNAGE
C CANOPY SIGNAGE
P PROJECTING SIGNAGE
W WALL MOUNTED SIGNAGE
A AWNING SIGNAGE

D/S/Y MODIFIERS FOR
RESPECTIVE BUILDINGS

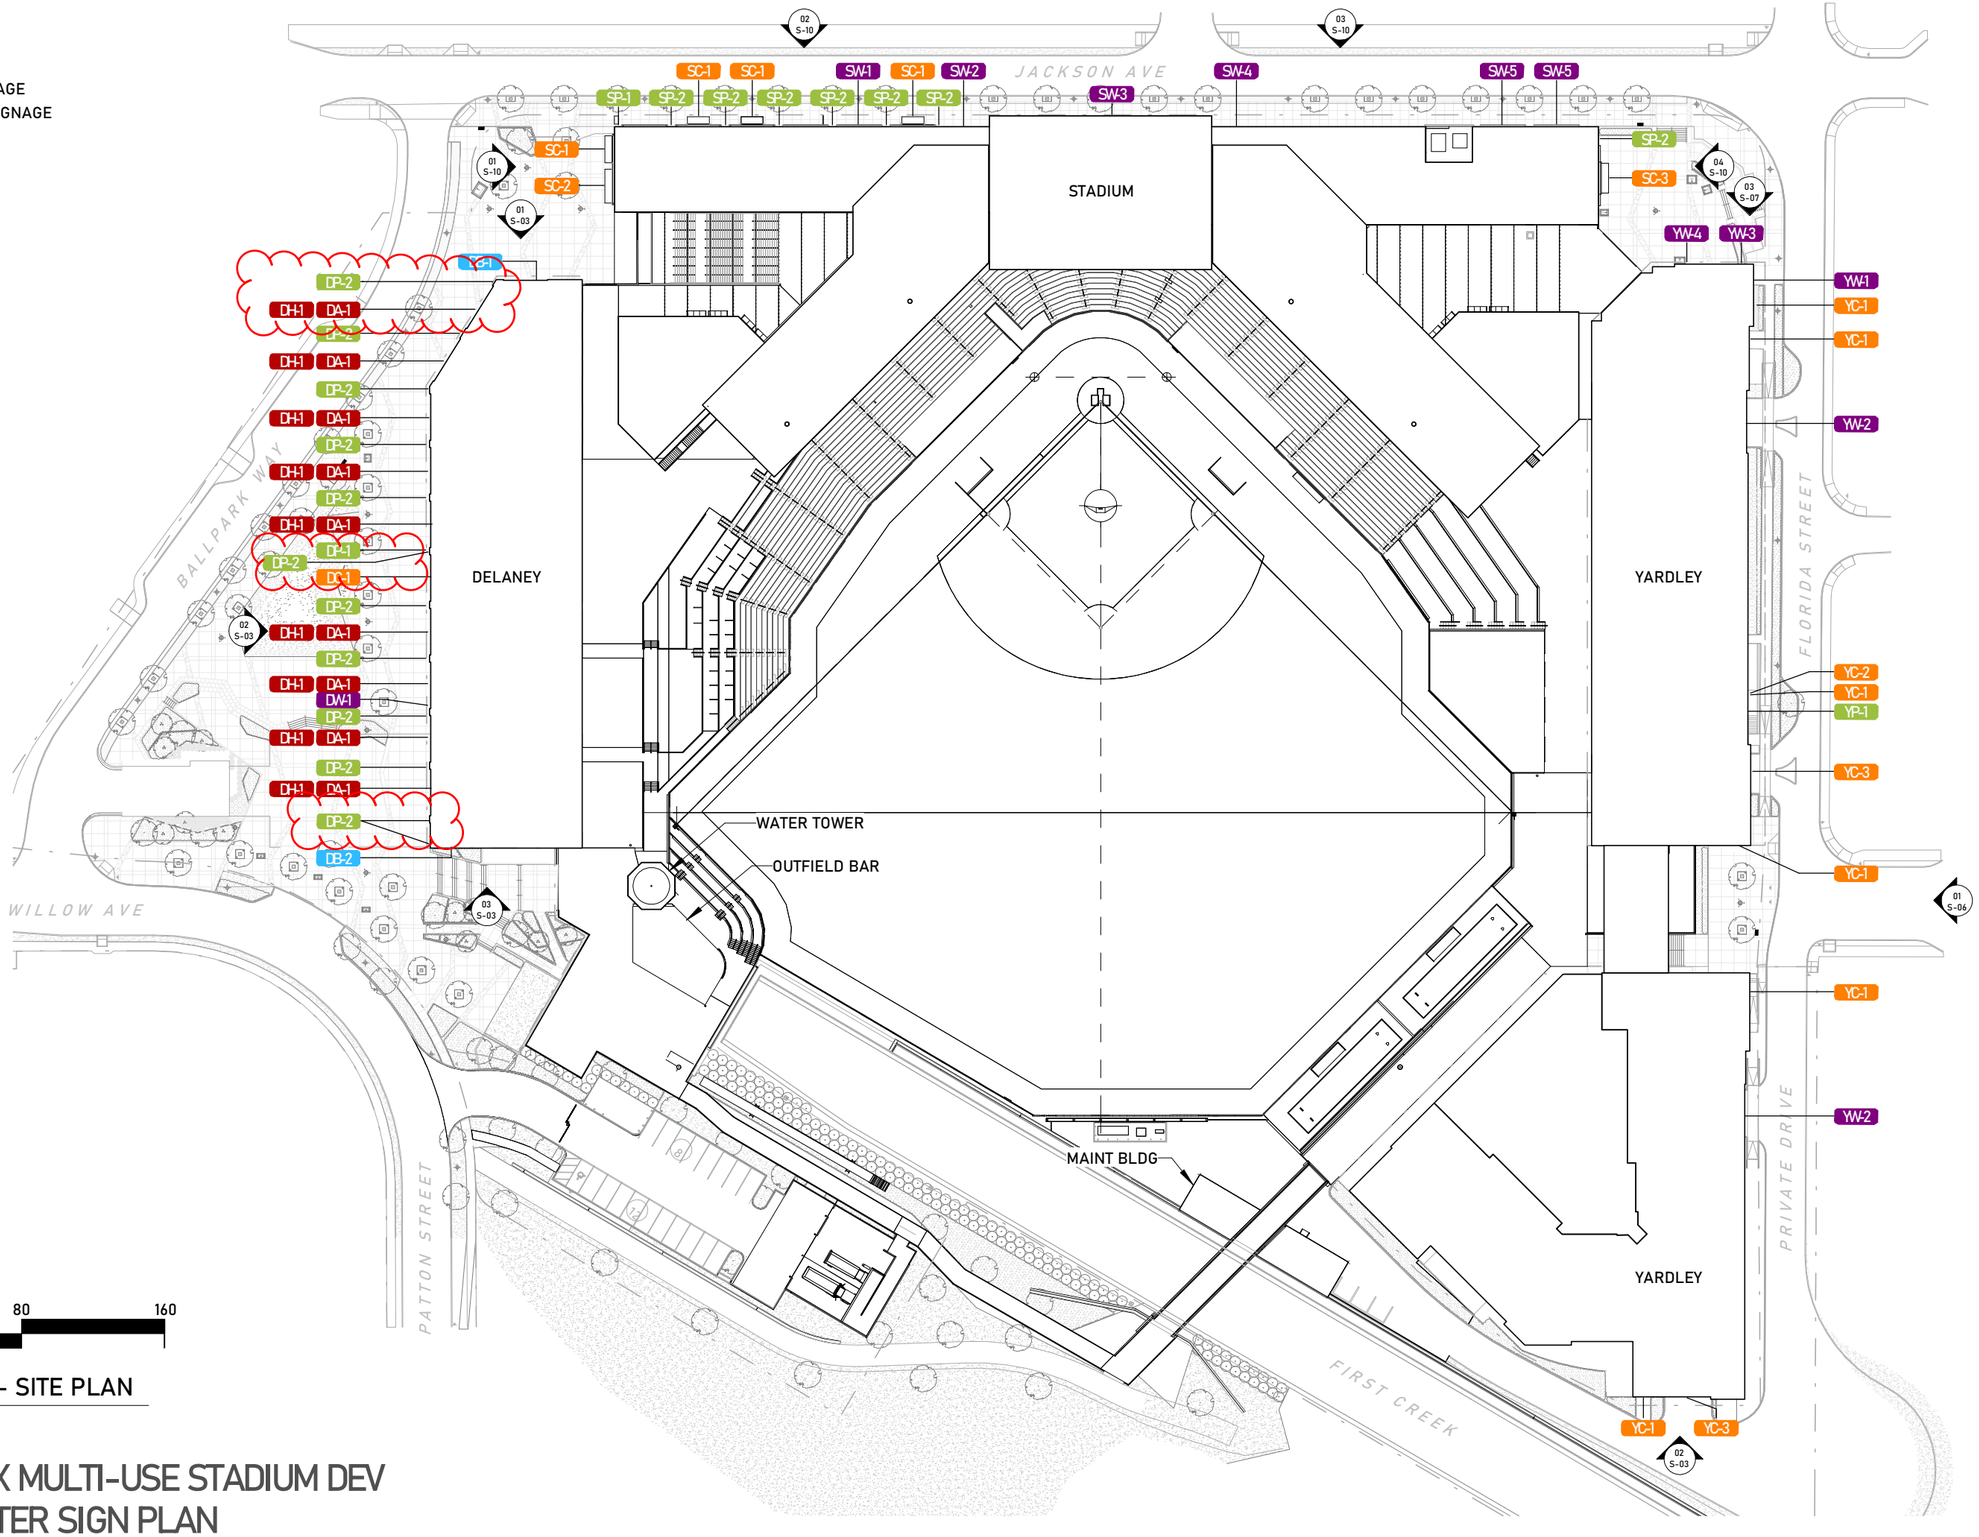

0 20 40 80 160

1 PHASE 1 - SITE PLAN

1" = 80'-0"

S-01

KNOX MULTI-USE STADIUM DEV
MASTER SIGN PLAN
PHASE 1

11-G-26-SU
rev. 10.9.2026

GEMAA
GEM Associated Architects: A Joint Venture
BarberMcMurry Architects + Design Innovation Architects

DELANEY SIGNAGE MASTER SCHEDULE

WALL MOUNTED SIGNAGE

SIGN NUMBER	SIGN TYPE	MAXIMUM ALLOWABLE SIGN AREA	MAX LENGTH	MAX HEIGHT	MAX PROJECTION FROM BUILDING	CLEAR HEIGHT ABOVE SIDEWALK	ILLUMINATION	NOTES	TOTAL AREA	TOTAL QUANTITY
DW-1	DELANEY ATTACHED WALL SIGN	200 SF	40'-0"	5'-0"	-	-	INTERNALLY LIT; NOT TO EXCEED 1 FC	CHANNEL CUT LETTERING	200 SF	1

PROJECTING SIGNAGE

SIGN NUMBER	SIGN TYPE	MAXIMUM ALLOWABLE SIGN AREA	MAX LENGTH	MAX HEIGHT	MAX PROJECTION FROM BUILDING	CLEAR HEIGHT ABOVE SIDEWALK	ILLUMINATION	NOTES	TOTAL AREA	TOTAL QUANTITY
DP-1	DELANEY PROJECTING BLADE SIGN	600 SF	-	50'-0"	12'-0"	5TH FLOOR	INTERNALLY LIT; NOT TO EXCEED 1 FC	-	600 SF	1
DP-2	TENANT PROJECTING BLADE SIGN	12 SF	-	2'-4"	5'-0"	MIN. 7'-0"	OPTIONAL; INTERNALLY LIT NOT TO EXCEED 1 FC	LETTERING UNIQUE TO TENANT	~~96 SF~~ 132 SF	~~UP TO 8~~ UP TO 11

AWNING SIGNAGE

SIGN NUMBER	SIGN TYPE	MAXIMUM ALLOWABLE SIGN AREA	MAX LENGTH	MAX HEIGHT	MAX PROJECTION FROM BUILDING	CLEAR HEIGHT ABOVE SIDEWALK	ILLUMINATION	NOTES	TOTAL AREA	TOTAL QUANTITY
DA-1.1	AWNING SIGNAGE	372 SF	31'-0"	12'-0"	-	-	NONE	VINYL LETTERING/ LOGO UNIQUE TO TENANT	~~2,976 SF~~ 3,348 SF	~~UP TO 8~~ UP TO 9
DA-1.2	AWNING SIGNAGE	42 SF	31'-0"	1'-4"	-	-	~~NONE~~ OPTIONAL; INTERNALLY LIT NOT TO EXCEED 1 FC	SIGNAGE CABINET W/ ROUTED ALUMINUM FACE/ PUSH THROUGH ACRYLIC LETTERING	~~336 SF~~ 378 SF	~~UP TO 8~~ UP TO 9

AWNING HANGING SIGNAGE

SIGN NUMBER	SIGN TYPE	MAXIMUM ALLOWABLE SIGN AREA	MAX LENGTH	MAX HEIGHT	MAX PROJECTION FROM BUILDING	CLEAR HEIGHT ABOVE SIDEWALK	ILLUMINATION	NOTES	TOTAL AREA	TOTAL QUANTITY
DH-1	AWNGING HANGING SIGNAGE	73 SF	31'-0"	2'-4"	-	7'-0"	~~NONE~~ OPTIONAL; INTERNALLY LIT NOT TO EXCEED 1 FC	CHANNEL CUT LETTERING OR SIGN CABINET	~~584 SF~~ 657 SF	~~UP TO 8~~ UP TO 9

CANOPY SIGNAGE

SIGN NUMBER	SIGN TYPE	MAXIMUM ALLOWABLE SIGN AREA	MAX LENGTH	MAX HEIGHT	MAX PROJECTION FROM BUILDING	CLEAR HEIGHT ABOVE SIDEWALK	ILLUMINATION	NOTES	TOTAL AREA	TOTAL QUANTITY
DC-1	DELANEY ENTRY SIGNAGE	30 SF	15'-0"	2'-0"	-	-	INTERNALLY LIT; NOT TO EXCEED 1 FC	CANOPY MOUNTED CHANNEL CUT LETTERING	30 SF	1


BANNER SIGNAGE

SIGN NUMBER	SIGN TYPE	MAXIMUM ALLOWABLE SIGN AREA	MAX LENGTH	MAX HEIGHT	MAX PROJECTION FROM BUILDING	CLEAR HEIGHT ABOVE SIDEWALK	ILLUMINATION	NOTES	TOTAL AREA	TOTAL QUANTITY
DB-1	DELANEY NORTH BANNER	384 SF	12'-0"	32'-0"	-	-	NONE	STRETCHED FABRIC MOUNTED TO EXTERIOR WALL	384 SF	1
DB-2	DELANEY SOUTH BANNER	264 SF	12'-0"	22'-0"	-	-	NONE	STRETCHED FABRIC MOUNTED TO EXTERIOR WALL	264 SF	1

SIDEWALK SIGNAGE


SIGN NUMBER	SIGN TYPE	MAXIMUM ALLOWABLE SIGN AREA	MAX LENGTH	MAX HEIGHT	MAX PROJECTION FROM BUILDING	CLEAR HEIGHT ABOVE SIDEWALK	ILLUMINATION	NOTES	TOTAL AREA	TOTAL QUANTITY
S-1	SIDEWALK SIGN	10 SF	2'-0"	5'-0"	WITHIN 15'-0" OF ENTRY	0'-0"	NONE	-	80 SF	UP TO 8

GEMAA
GEM Associated Architects: A Joint Venture
BarberMcMurry Architects + Design Innovation Architects

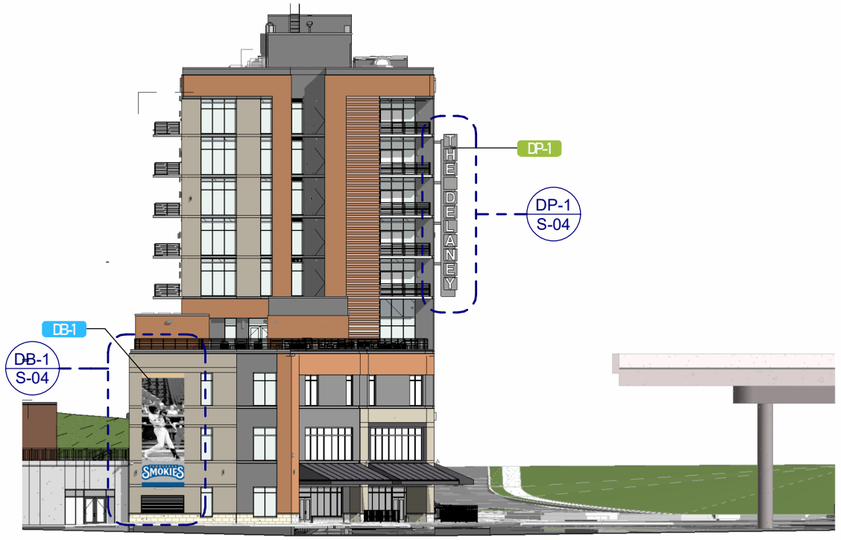


01 NORTH ELEVATION

1" = 40'-0"

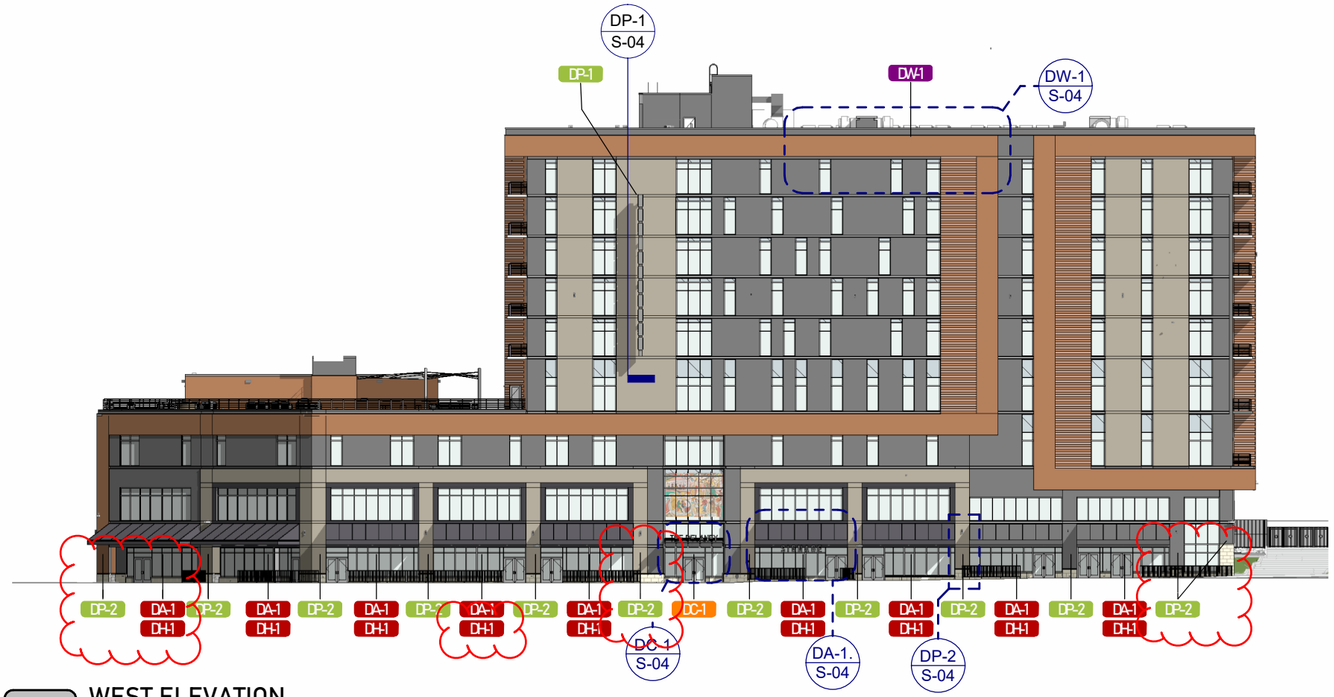

02 WEST ELEVATION

1" = 40'-0"

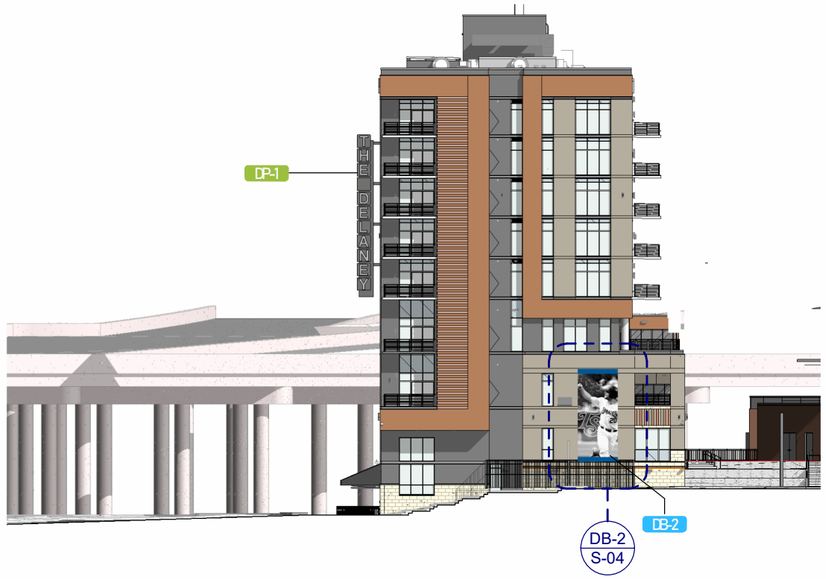

03 SOUTH ELEVATION

1" = 40'-0"

	DELANEY
*PRIMARY BUILDING ELEVATION:	32,555.3 sqf
NORTH ANGLE ELEVATION:	3,494.97 sqf
WEST ELEVATION:	29,060.33 sqf
TOTAL SIGNAGE AREA:	5,615 TOTAL SIGNAGE SQF (17.47%) ~~5,134 total signage sqf~~ (15.77%)
NORTH ELEVATION SIGNAGE:	384 sqf
NORTH ANGLE ELEVATION SIGNAGE:	~~457 sqf~~ 914 SQF
SOUTH ELEVATION SIGNAGE:	264 sqf
EAST ELEVATION SIGNAGE:	N/A
WEST ELEVATION SIGNAGE:	***~~4,029 sqf~~ 4,053 SQF


*WALL AREA CALCULATIONS INCLUDE GLAZING

***BASED ON WORST CASE SCENARIO (DA-1.1, AND DH-1 ADDED TOGETHER) | DA-1.2 NOT INCLUDED IN CALCULATIONS

S-03

KNOX MULTI-USE STADIUM DEV
MASTER SIGN PLAN
PHASE 1

GEMAA
GEM Associated Architects: A Joint Venture
BarberMcMurry Architects + Design Innovation Architects

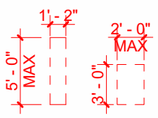


MUST BE PLACED ON A SIDEWALK WITHIN PUBLIC RIGHT-OF-WAY OR PUBLIC PROPERTY WITHIN 15 FEET OF THE ENTRY TO A BUSINESS OR OUTDOOR SPACE ASSOCIATED WITH THE BUSINESS

THERE IS NO REQUIRED MINIMUM SPACING BETWEEN SIDEWALK SIGNS FURNISHED BY DIFFERENT RETAIL TENANTS, HOWEVER, EACH TENANT SHALL BE LIMITED TO 1 SIGN.


S-1 SIDEWALK SIGN


3/32" = 1'-0"

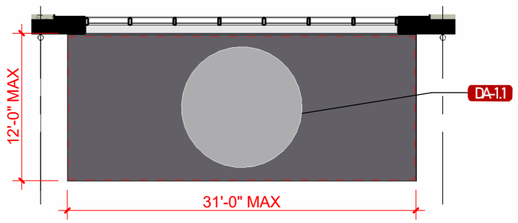

DA-1 AWNING SIGNAGE - TOP VIEW


3/32" = 1'-0"

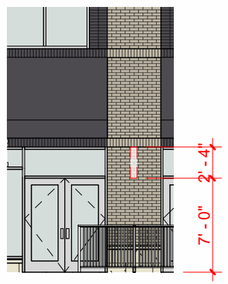

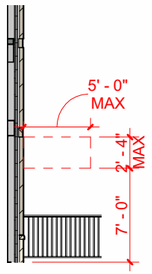


DP-2 TENANT BLADE SIGN

3/32" = 1'-0"

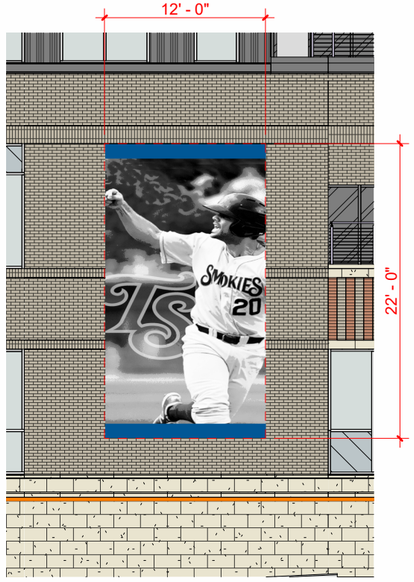


DB-2 SOUTH BANNER

3/32" = 1'-0"

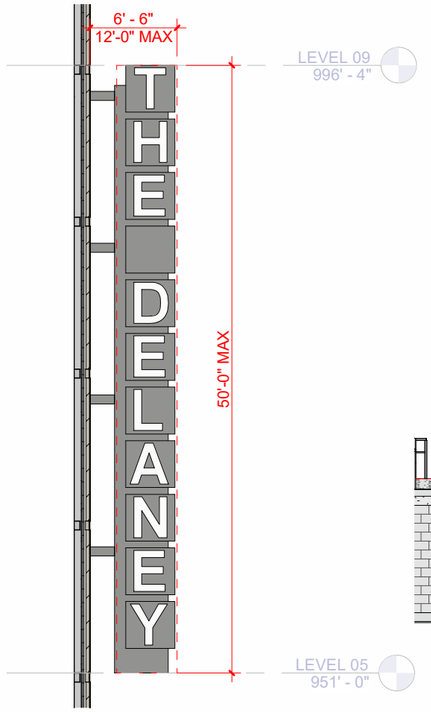


DP-1 DELANEY BLADE SIGN


3/32" = 1'-0"

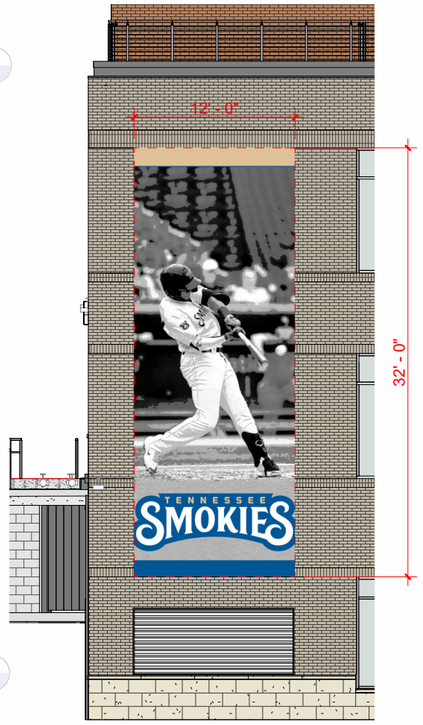


DB-1 NORTH BANNER

3/32" = 1'-0"

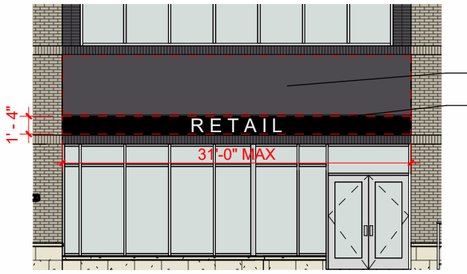

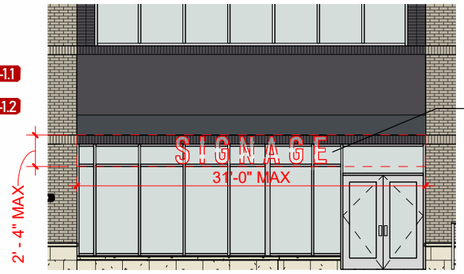

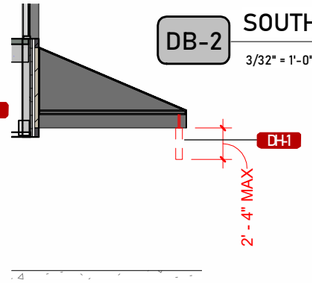


DA-1. AWNING SIGNAGE

3/32" = 1'-0"


DH-1 AWNING HANGING SIGNAGE (ALT)

3/32" = 1'-0"

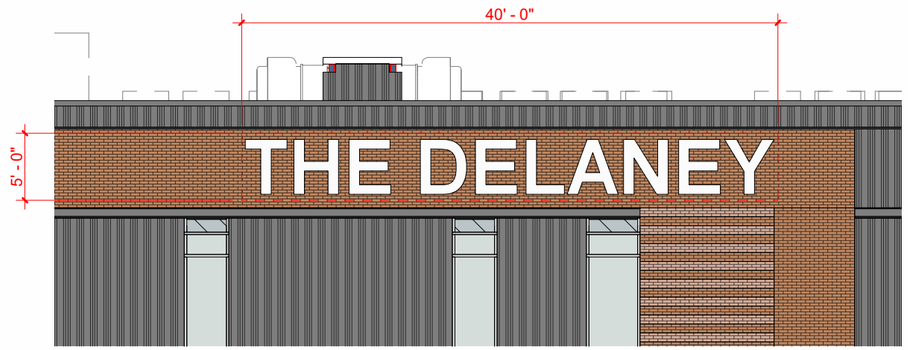

DW-1 BUILDING ATTACHED WALL SIGN

3/32" = 1'-0"

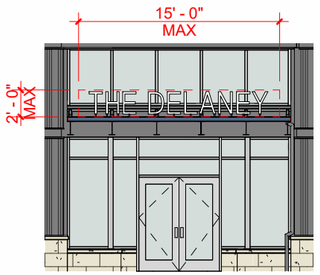

DC-1 DELANEY ENTRY SIGNAGE

3/32" = 1'-0"

	DELANEY
*PRIMARY BUILDING ELEVATION:	32,555.3 sqf
NORTH ANGLE ELEVATION:	3,494.97 sqf
WEST ELEVATION:	29,060.33 sqf
TOTAL SIGNAGE AREA:	5,134 total signage sqf (15.77%)
NORTH ELEVATION SIGNAGE:	384 sqf
NORTH ANGLE ELEVATION SIGNAGE:	457 sqf
SOUTH ELEVATION SIGNAGE:	264 sqf
EAST ELEVATION SIGNAGE:	N/A
WEST ELEVATION SIGNAGE:	***4,029 sqf

*WALL AREA CALCULATIONS INCLUDE GLAZING

***BASED ON WORST CASE SCENARIO (DA-1.1, AND DH-1 ADDED TOGETHER) | DA-1.2 NOT INCLUDED IN CALCULATIONS

KNOX MULTI-USE STADIUM DEV
MASTER SIGN PLAN
PHASE 1

No changes from approved plan

GEMAA
GEM Associated Architects: A Joint Venture
BarberMcMurry Architects + Design Innovation Architects